U.S. DEPARTMENT OF HOMELAND SECURITY

Federal Emergency Management Agency

National Flood Insurance Program

OMB No. 1660-0008

Expiration Date: November 30, 2022

ELEVATION CERTIFICATE

Important: Follow the instructions on pages 1–9.

Copy all pages of this Elevation Certificate and all attachments for (1) community official, (2) insurance agent/company, and (3) building owner.

| SECTION A - PROPERTY INFORMATION | | | | FOR INSUR | ANCE COMPANY USE | |
|--|------------------------------|------------|-----------------------------------|----------------------|-----------------------------------|------------------------------------|
| A1. Building Owner's Name | | | | Policy Numb | per: | |
| Rose Francisco | | | | | | |
| A2. Building Street Address (including Apt., Unit, Suite, and/or Bldg. No.) or P.O. Route and Box No.#6148 US 64 | | | | Company N | AIC Number: | |
| City Bloomfield | | | State New Mex | kico | ZIP Code 87413 | |
| A3. Property Description (L Lot 13A-1 Valle Verde Subd | | ax Parcel | Number, Leg | gal Description, etc | c.) | |
| A4. Building Use (e.g., Res | dential, Non-Residential, | Addition | , Accessory, e | etc.) Residentia | I (single wide mobil | e home) |
| A5. Latitude/Longitude: La | t. 36.705887 | Long1 | 08.026519 | Horizontal | Datum: NAD 1 | 927 🔀 NAD 1983 |
| A6. Attach at least 2 photog | raphs of the building if the | e Certific | ate is being u | sed to obtain floor | d insurance. | |
| A7. Building Diagram Numb | er <u>1A</u> | | | | | |
| A8. For a building with a cra | wlspace or enclosure(s): | | | | | |
| a) Square footage of cr | awlspace or enclosure(s) | | | 514.00 sq ft | | |
| b) Number of permaner | nt flood openings in the cr | awlspace | e or enclosure | e(s) within 1.0 foot | above adjacent gra | ide 4 |
| c) Total net area of floo | d openings in A8.b | | 512.00 sq in | | | |
| d) Engineered flood op | enings? 🗌 Yes 🗵 N | No | | | | |
| A9. For a building with an at | tached garage: | | | | | |
| a) Square footage of at | tached garage | | N/A sq ft | | | |
| b) Number of permaner | nt flood openings in the at | tached g | arage within | 1.0 foot above adja | acent grade N/A | |
| c) Total net area of floo | d openings in A9.b | | N/A sq | in | | |
| d) Engineered flood ope | enings? ☐ Yes 🖂 N | 10 | | | | |
| , | | | | | | |
| | SECTION B - FLOOD | INSURA | NCE RATE | MAP (FIRM) INF | ORMATION | 1 |
| B1. NFIP Community Name | & Community Number | | B2. County | Name | | B3. State |
| San Juan County/350064 | | | San Juan | | | New Mexico |
| B4. Map/Panel B5. Suf Number | fix B6. FIRM Index Date | Effe | RM Panel ective/ vised Date | B8. Flood Zone(s) | B9. Base Flood E (Zone AO, use | levation(s) e Base Flood Depth) |
| 35045C1033F F | 08-15-2010 | 08-15-2 | | A | Not Determined | |
| B10. Indicate the source of the Base Flood Elevation (BFE) data or base flood depth entered in Item B9: ☐ FIS Profile ☐ FIRM ☐ Community Determined ☐ Other/Source: | | | | | | |
| B11. Indicate elevation datum used for BFE in Item B9: NGVD 1929 NAVD 1988 Other/Source: | | | | | | |
| B12. Is the building located in a Coastal Barrier Resources System (CBRS) area or Otherwise Protected Area (OPA)? 🗌 Yes 🔀 No | | | | | | |
| Designation Date: CBRS OPA | | | | | | |
| _ | | | _ | | | |
| | | | | | | |

ELEVATION CERTIFICATE

OMB No. 1660-0008 Expiration Date: November 30, 2022

| IMPORTANT: In these spaces, copy the corresponding information from Section A. | | | FOR INSURANCE COMPANY USE |
|--|---|--|--|
| #6148 US 64 | | | Policy Number: |
| City Bloomfield | State ZIP (New Mexico 8741 | | Company NAIC Number |
| SECTION C - E | BUILDING ELEVATION INFORMAT | ION (SURVEY RE | QUIRED) |
| C1. Building elevations are based on: *A new Elevation Certificate will be re C2. Elevations – Zones A1–A30, AE, AH, Complete Items C2.a–h below accord Benchmark Utilized: WGS 1984 Indicate elevation datum used for the NGVD 1929 NAVD 19 Datum used for building elevations m a) Top of bottom floor (including base b) Top of the next higher floor c) Bottom of the lowest horizontal str d) Attached garage (top of slab) e) Lowest elevation of machinery or (Describe type of equipment and I | Construction Drawings* Build Equired when construction of the building A (with BFE), VE, V1–V30, V (with BFE) and the building diagram specified in Vertical Datum: Pelevations in items a) through h) below the same as that used for the Beament, crawlspace, or enclosure floor) Puctural member (V Zones only) | ding Under Construing is complete. FE), AR, AR/A, AR/A, Item A7. In Puerto WGS 1984 v. FE. 5 | Check the measurement used. Check the meters N/A |
| g) Highest adjacent (finished) grade | next to building (HAG) | 5 | 638.6 |
| h) Lowest adjacent grade at lowest e structural support | elevation of deck or stairs, including | 5 | 638.4 🔀 feet 🗌 meters |
| SECTION D - | SURVEYOR, ENGINEER, OR ARC | HITECT CERTIFI | CATION |
| This certification is to be signed and seale I certify that the information on this Certific statement may be punishable by fine or in Were latitude and longitude in Section A purchase Certifier's Name Robert A. Echols, Jr., PE | cate represents my best efforts to interprisonment under 18 U.S. Code, Sect | pret the data availa | law to certify elevation information. ble. I understand that any false Check here if attachments. |
| Title President Company Name Cheney-Walters-Echols, Inc. Address 909 W. Apache City Farmington | State New Mexico | ZIP Code 87401 | S & SOOD S S S S S S S S S S S S S S S S S |
| Signature Zules | Date 2/123/12 | Telephone (505) 327-3303 | Ext. |
| Copy all pages of this Elevation Certificate a | | ficial, (2) insurance | agent/company, and (3) building owner. |
| Comments (including type of equipment a | nd location, per C2(e), if applicable) | | |

ELEVATION CERTIFICATE

OMB No. 1660-0008 Expiration Date: November 30, 2022

| IMPORTANT: In these spaces, copy the corresponding | FOR INSURANCE COMPANY USE | | | |
|---|---|---|--|--|
| Building Street Address (including Apt., Unit, Suite, and/o No. #6148 US 64 | r Bldg. No.) or P.O. Rou | te and Box | Policy Number: | |
| City Sta Bloomfield Ne | w Mexico 8741 | Code 13 | Company NAIC Number | |
| SECTION E – BUILDING ELEY FOR ZONE A | VATION INFORMATIO AO AND ZONE A (WIT | N (SURVEY NOT HOUT BFE) | REQUIRED) | |
| For Zones AO and A (without BFE), complete Items E1–E5. If the Certificate is intended to support a LOMA or LOMR-F request, complete Sections A, B, and C. For Items E1–E4, use natural grade, if available. Check the measurement used. In Puerto Rico only, enter meters. | | | | |
| E1. Provide elevation information for the following and characteristics the highest adjacent grade (HAG) and the lowest adjacent Top of bottom floor (including basement, | | es to show whether | the elevation is above or below | |
| crawlspace, or enclosure) is b) Top of bottom floor (including basement, | 0.1 | ⊠ feet ☐ meters | s above or 🗵 below the HAG. | |
| crawlspace, or enclosure) is | 0.1 | ✓ feet ☐ meters | | |
| E2. For Building Diagrams 6–9 with permanent flood ope the next higher floor (elevation C2.b in the diagrams) of the building is | enings provided in Section | feet meters | | |
| E3. Attached garage (top of slab) is | | feet meters | s above or below the HAG. | |
| E4. Top of platform of machinery and/or equipment servicing the building is | | ☐ feet ☐ meters | s above or below the HAG. | |
| E5. Zone AO only: If no flood depth number is available, floodplain management ordinance? Yes N | | | cordance with the community's certify this information in Section G. | |
| SECTION F - PROPERTY OWNE | R (OR OWNER'S REP | RESENTATIVE) CE | RTIFICATION | |
| The property owner or owner's authorized representative community-issued BFE) or Zone AO must sign here. The | who completes Sections statements in Sections a | s A, B, and E for Zo A, B, and E are cor | ne A (without a FEMA-issued or rect to the best of my knowledge. | |
| Property Owner or Owner's Authorized Representative's Robert A. Echols, Jr., PE | Name | | | |
| Address 909 W. Apache | City Farmingto | Sta n N e | ate ZIP Code ew Mexico 87401 | |
| Signature W | Date 1 123/1 | | lephone 05) 327-3303 | |
| Comments | | | | |
| | | | | |
| | | | | |
| | | | ☐ Check here if attachments. | |

ELEVATION CERTIFICATE

OMB No. 1660-0008 Expiration Date: November 30, 2022

| IMPORTANT: In these spaces, copy the corre | sponding information f | rom Section A. | FOR INSURANCE COMPANY USE |
|--|------------------------------|------------------------|---|
| Building Street Address (including Apt., Unit, Su #6148 US 64 | ite, and/or Bldg. No.) or F | P.O. Route and Box No | |
| City Bloomfield | State New Mexico | ZIP Code 87413 | Company NAIC Number |
| SECTIO | N G - COMMUNITY INF | ORMATION (OPTION | AL) |
| The local official who is authorized by law or ordinance to administer the community's floodplain management ordinance can complete Sections A, B, C (or E), and G of this Elevation Certificate. Complete the applicable item(s) and sign below. Check the measurement used in Items G8–G10. In Puerto Rico only, enter meters. | | | |
| G1. The information in Section C was taken from other documentation that has been signed and sealed by a licensed surveyor, engineer, or architect who is authorized by law to certify elevation information. (Indicate the source and date of the elevation data in the Comments area below.) | | | |
| G2. A community official completed Section or Zone AO. | on E for a building located | l in Zone A (without a | FEMA-issued or community-issued BFE) |
| G3. The following information (Items G4–C | G10) is provided for comr | munity floodplain mana | agement purposes. |
| G4. Permit Number | G5. Date Permit Issued | | G6. Date Certificate of Compliance/Occupancy Issued |
| G7. This permit has been issued for: | New Construction S | ubstantial Improvemer | nt |
| G8. Elevation of as-built lowest floor (including of the building: | basement) | | feet meters Datum |
| G9. BFE or (in Zone AO) depth of flooding at the | ne building site: | | feet meters Datum |
| G10. Community's design flood elevation: | | [|] feet |
| Local Official's Name | | Title | |
| Community Name | | Telephone | |
| Signature | | Date | |
| Comments (including type of equipment and local | ation, per C2(e), if applica | able) | |
| | | | |
| | | | |
| | | | ☐ Check here if attachments. |

BUILDING PHOTOGRAPHS

ELEVATION CERTIFICATE

See Instructions for Item A6.

OMB No. 1660-0008

Expiration Date: November 30, 2022

| IMPORTANT: In these spaces, copy the corresponding information from Section A. | | | FOR INSURANCE COMPANY USE |
|---|------------|----------|---------------------------|
| Building Street Address (including Apt., Unit, Suite, and/or Bldg. No.) or P.O. Route and Box No. #6148 US 64 | | | Policy Number: |
| City | State | ZIP Code | Company NAIC Number |
| Bloomfield | New Mexico | 87413 | |

If using the Elevation Certificate to obtain NFIP flood insurance, affix at least 2 building photographs below according to the instructions for Item A6. Identify all photographs with date taken; "Front View" and "Rear View"; and, if required, "Right Side View" and "Left Side View." When applicable, photographs must show the foundation with representative examples of the flood openings or vents, as indicated in Section A8. If submitting more photographs than will fit on this page, use the Continuation Page.

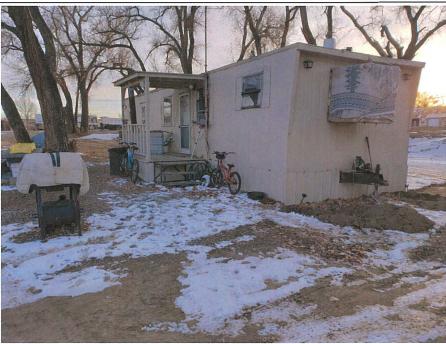


Photo One

Photo One Caption Clear Photo One

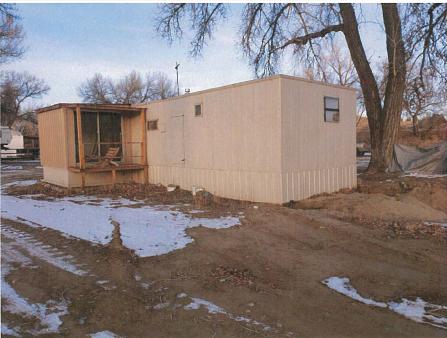


Photo Two

Photo Two Caption

Clear Photo Two

BUILDING PHOTOGRAPHS

ELEVATION CERTIFICATE

Continuation Page

OMB No. 1660-0008 Expiration Date: November 30, 2022

| IMPORTANT: In these spaces, copy the corresponding information from Section A. | | | FOR INSURANCE COMPANY USE |
|---|------------|----------|---------------------------|
| Building Street Address (including Apt., Unit, Suite, and/or Bldg. No.) or P.O. Route and Box No. #6148 US 64 | | | Policy Number: |
| City | State | ZIP Code | Company NAIC Number |
| Bloomfield | New Mexico | 87413 | |


If submitting more photographs than will fit on the preceding page, affix the additional photographs below. Identify all photographs with: date taken; "Front View" and "Rear View"; and, if required, "Right Side View" and "Left Side View." When applicable, photographs must show the foundation with representative examples of the flood openings or vents, as indicated in Section A8.



Photo Three

Clear Photo Three Photo Three Caption

Photo Four

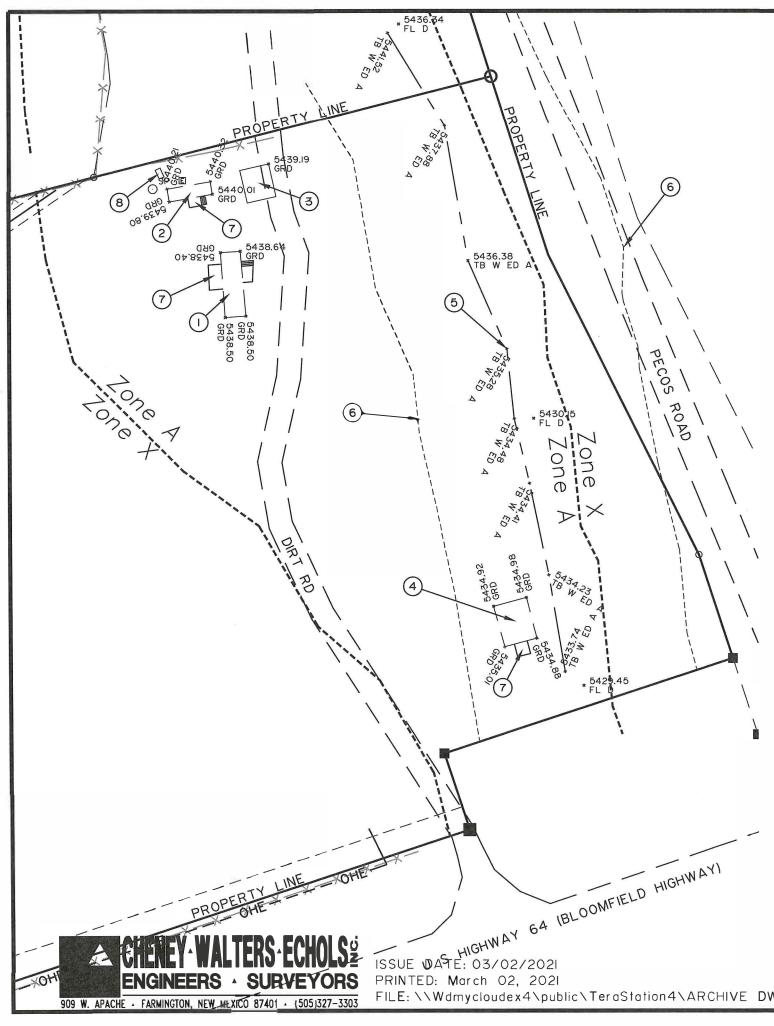

FLOOD ELEVATION CERTIFICATE
6148 US 64/ 14 ROAD 5117
No.FOR WIDE MOBILEHOME
SINGLE NEW MEXICO 87413
BLOOMFIELD, FOR
ROSE FRANCISCO


KEYED NOTES:

- () 514.00 sf SINGLE WIDE MOBILE HOME FINISH FLOOR ELEVATION = 5641.06.
- (2) FIFTH WHEEL CAMPER TRAILER WITH FINISH FLOOR = 5442.00.
- (3) 384.0 sf CARPORT WITH FINISH GRADE 5439.20.
- (4) 552.0 sf SHED WITH FINISHED GRADE = 5435.00.
- (5) TOP OF WEST EDGE OF SAN JUAN RIVER TRIBUTARY 43 ARROYO.
- (6) 60.0' ARROYO BUILDING SETBACK.
- (7) COVERED PORCH.
- (8) 20.0 sf SHED.


DETERMINED BASE FLOOD ELEVATION

- I. DATA FROM PANEL 35045CI035F REVISED AUGUST 5, 2010 IS ZONE A. 2. SEE SHEET No. 2 OF 2 FOR FIRM MAP INFORMATION.
- 3. THERE IS NO DETERMINED BASE FLOOD ELEVATION.



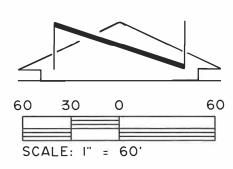

FILE: \\Wdmycloudex4\public\TeraStation4\ARCHIVE DWGS\DRAWINGS\DWG-HWS\2019\19172\19172 6148FLD CERT.d\SHEET No. 1 OF 2

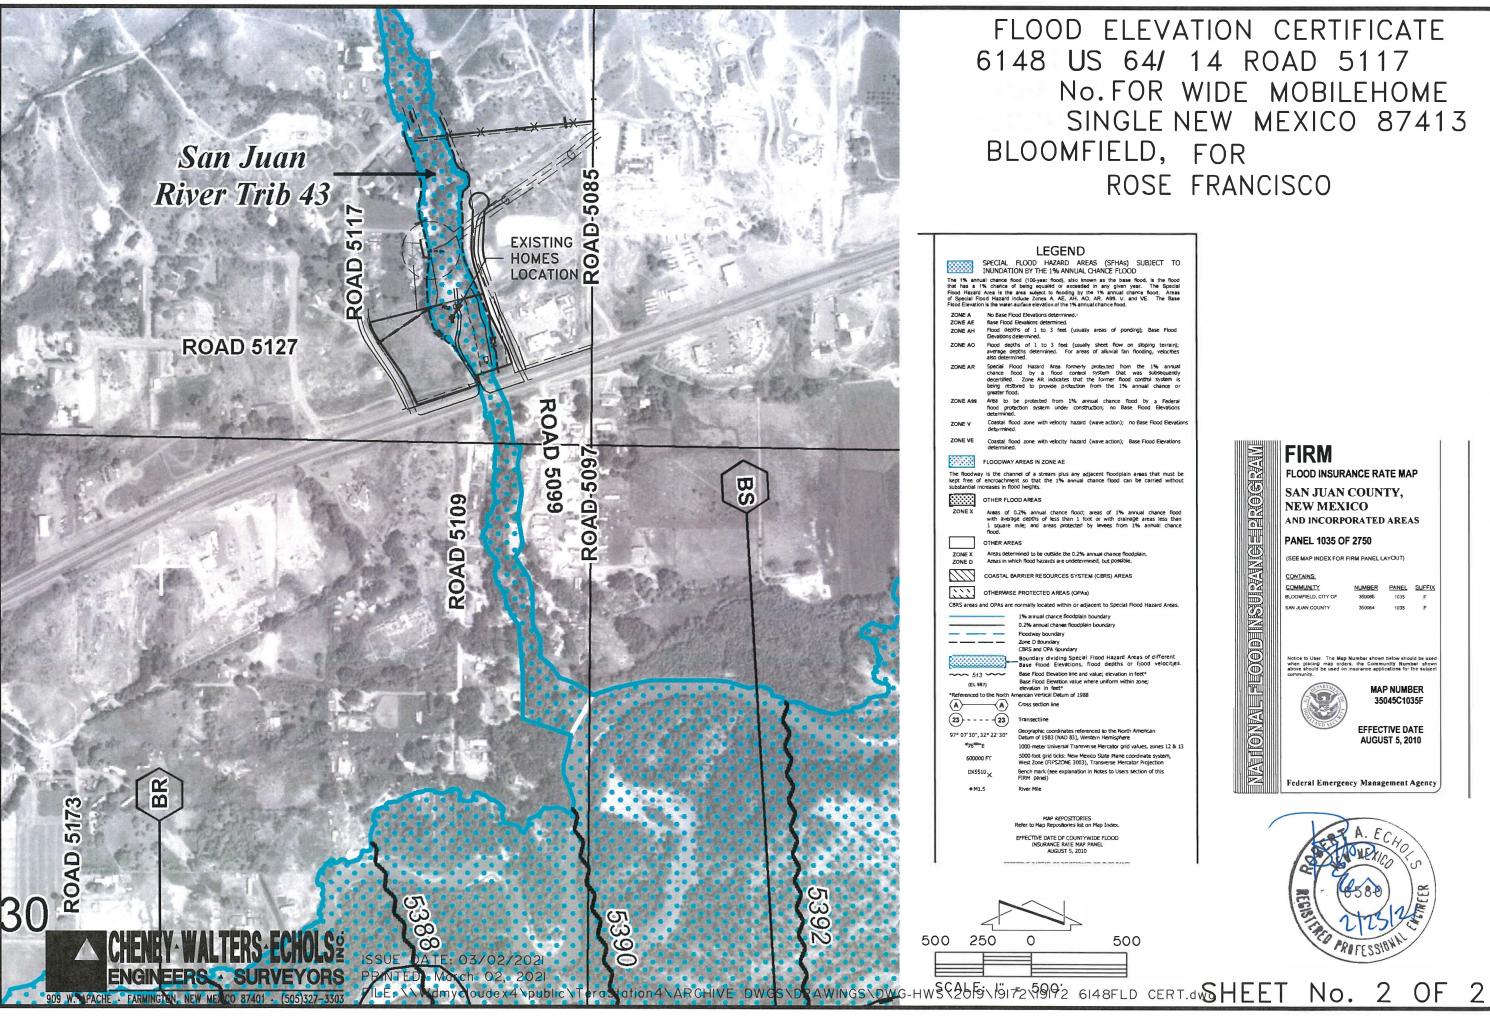

6148 US 64/ 14 ROAD 5117 No. FOR WIDE MOBILEHOME SINGLE NEW MEXICO 87413

