U.S. DEPARTMENT OF HOMELAND SECURITY Federal Emergency Management Agency National Flood Insurance Program

OMB No. 1660-0008 Expiration Date: November 30, 2022

ELEVATION CERTIFICATE

Important: Follow the instructions on pages 1-9.

Copy all pages of this Elevation Certificate and all attachments for (1) community official, (2) insurance agent/company, and (3) building owner.

SECTION A - PROPERTY INFORMATION					FOR INSUR	ANCE COMPANY USE	
A1. Building Owner's	Name					Policy Numb	oer:
Garrett Chavez					···		
A2. Building Street Address (including Apt., Unit, Suite, and/or Bldg. No.) or P.O. Route and Box No.1790 B1 NM 173				Company N	AIC Number:		
City				State		ZIP Code	
Navajo Dam	14			New Mex		87419	
	•	nd Block Numbers, Ta states Subdivision No		Number, Leg	jal Description, etc	2.)	
A4. Building Use (e.g	g., Residen	tial, Non-Residential,	Addition,	Accessory, e	etc.) Recreation	nal/Non-Residential	(24'X60')
A5. Latitude/Longitud	de: Lat. <u>36</u>	8.8056010	Long1	07.697394	Horizontal	Datum: NAD 1	927 🔀 NAD 1983
A6. Attach at least 2	photograp	hs of the building if the	e Certific	ate is being u	sed to obtain flood	d insurance.	
A7. Building Diagram	n Number	1B					
A8. For a building wi	th a crawls	pace or enclosure(s):					
a) Square footag	ge of crawl	space or enclosure(s)			N/A sq ft		
b) Number of pe	rmanent flo	ood openings in the cra	awlspace	e or enclosure	e(s) within 1.0 foot	above adjacent gra	ide N/A
c) Total net area	of flood op	penings in A8.b		N/A sqin			
d) Engineered fl	ood openir	gs? 🗌 Yes 🗵 N	lo				
A9. For a building wit	•		.0				
a) Square footag	ge of attach	ed garage		N/A sq ft			
			ached a	arage within	1.0 foot above adia	acent grade N/A	
b) Number of permanent flood openings in the attached garage within 1.0 foot above adjacent grade N/A c) Total net area of flood openings in A9.b N/A sq in							
d) Engineered flo							
u) Engineered in	ood openin	ga: Lea Mi	10				
	SE	CTION B - FLOOD I	NSURA	NCE RATE	MAP (FIRM) INF	ORMATION	
B1. NFIP Community	Name & C	Community Number		B2. County	Name		B3. State
B4. Map/Panel I	B5. Suffix	B6. FIRM Index Date	Effe	RM Panel ective/	B8. Flood Zone(s)	B9. Base Flood E (Zone AO, use	levation(s) e Base Flood Depth)
800/2750	F	08-05-2010	08-05-2	vised Date 2010	A	5674.85	
B10. Indicate the source of the Base Flood Elevation (BFE) data or base flood depth entered in Item B9:							
☐ FIS Profile ☐ FIRM ☐ Community Determined ☒ Other/Source: Interpolation of #7 Road 4267 11/12/07							
B11. Indicate elevation datum used for BFE in Item B9: NGVD 1929 NAVD 1988 🔀 Other/Source:							
B12. Is the building located in a Coastal Barrier Resources System (CBRS) area or Otherwise Protected Area (OPA)? 🗌 Yes 🗵 No							
Designation Date: CBRS OPA							

ELEVATION CERTIFICATE

IMPORTANT: In these spaces, copy the corresponding information from Section 1.	FOR INSURANCE COMPANY USE				
Building Street Address (including Apt., Unit, Suite, and/or Bldg. No.) or P.O. Route 1790 B1 NM 173	Policy Number:				
City State ZIP C	ode	Company NAIC Number			
Navajo Dam New Mexico 87419	9				
SECTION C – BUILDING ELEVATION INFORMATI	ON (SURVEY RE	EQUIRED)			
*A new Elevation Certificate will be required when construction of the building C2. Elevations – Zones A1–A30, AE, AH, A (with BFE), VE, V1–V30, V (with BFE Complete Items C2.a–h below according to the building diagram specified in Benchmark Utilized: WGS 1984 Vertical Datum: Vertical	E), AR, AR/A, AR/A Item A7. In Puerto VGS 1984	AE, AR/A1–A30, AR/AH, AR/AO. o Rico only, enter meters. Check the measurement used. N/A			
g) Highest adjacent (finished) grade next to building (HAG)	5	685.5 X feet meters			
 h) Lowest adjacent grade at lowest elevation of deck or stairs, including structural support 		N/A feet meters			
SECTION D – SURVEYOR, ENGINEER, OR ARCI	HITECT CERTIFI	CATION			
This certification is to be signed and sealed by a land surveyor, engineer, or architect authorized by law to certify elevation information. I certify that the information on this Certificate represents my best efforts to interpret the data available. I understand that any false statement may be punishable by fine or imprisonment under 18 U.S. Code, Section 1001. Were latitude and longitude in Section A provided by a licensed land surveyor? Yes No Check here if attachments.					
Certifier's Name License Number					
Robert A. Echols, Jr., PE 6580 Title President Company Name Cheney-Walters-Echols, Inc. Address 909 W. Apache City Farmington State New Mexico	ZIP Code 87401	TO PROFESSIONAL			
Signature Date	Telephone	Ext.			
8 11512	(505) 327-3303	1/0/1 ""			
Copy all pages of this Elevation Certificate and all attachments for (1) community office Comments (including type of equipment and location, per C2(e), if applicable) B10. Interpolation of Elevation Certificate for #7 Road 4267 11/12/07	cial, (2) insurance :	agent/company, and (3) building owner.			

ELEVATION CERTIFICATE

IMPORTANT: In these spaces, copy the corresponding	FOR INSURANCE	COMPANY USE		
Building Street Address (including Apt., Unit, Suite, and/o	or Bldg. No.) or P.O. Ro	ute and Box No.	Policy Number:	
City	ate ZIP	Code	Company NAIC Nur	mber
Navajo Dam Ne	ew Mexico 874	19		
SECTION E – BUILDING ELE FOR ZONE	VATION INFORMATION AO AND ZONE A (WI	ON (SURVEY NOT THOUT BFE)	REQUIRED)	
For Zones AO and A (without BFE), complete Items E1–E5. If the Certificate is intended to support a LOMA or LOMR-F request, complete Sections A, B,and C. For Items E1–E4, use natural grade, if available. Check the measurement used. In Puerto Rico only, enter meters.				
E1. Provide elevation information for the following and check the appropriate boxes to show whether the elevation is above or below the highest adjacent grade (HAG) and the lowest adjacent grade (LAG). a) Top of bottom floor (including basement,				
crawlspace, or enclosure) is	0.0		rs 🗵 above or 🗌	below the HAG.
 Top of bottom floor (including basement, crawlspace, or enclosure) is 	0.0	⊠ feet ☐ meter	rs 🗵 above or 🗌	below the LAG.
E2. For Building Diagrams 6–9 with permanent flood op	enings provided in Secti	on A Items 8 and/or	9 (see pages 1-2 of	Instructions),
the next higher floor (elevation C2.b in the diagrams) of the building is	N/A	feet meter	rs above or	below the HAG.
E3. Attached garage (top of slab) is	N/A	feet meter	rs 🔲 above or 🔲	below the HAG.
E4. Top of platform of machinery and/or equipment servicing the building is	N/A	feet meter	rs above or	below the HAG.
E5. Zone AO only: If no flood depth number is available floodplain management ordinance?	, is the top of the bottom No Unknown. Th	floor elevated in ac e local official must	cordance with the co certify this information	mmunity's n in Section G.
SECTION F - PROPERTY OWN	ER (OR OWNER'S REP	RESENTATIVE) CI	ERTIFICATION	
The property owner or owner's authorized representative community-issued BFE) or Zone AO must sign here. The	e who completes Section e statements in Sections	ns A, B, and E for Zo A, B, and E are co	one A (without a FEM rect to the best of my	A-issued or knowledge.
Property Owner or Owner's Authorized Representative's Robert A. Echols, Jr. PE	Name			
Address	City			ZIP Code
909 W. Apache	Farmingt			87401
Signature Shape &	Date 7 (1.5)		elephone 05) 327-3303	
Comments				
			Check here	if attachments.

ELEVATION CERTIFICATE

IMPORTANT: In these spaces, copy the corre	FOR INSURANCE COMPANY USE			
Building Street Address (including Apt., Unit, St. 1790 B1 NM 173	Policy Number:			
City Navajo Dam	State New Mexico	ZIP Code 87419	Company NAIC Number	
SECTIO	N G - COMMUNITY INF	FORMATION (OPTIONAL)		
The local official who is authorized by law or ordinance to administer the community's floodplain management ordinance can complete Sections A, B, C (or E), and G of this Elevation Certificate. Complete the applicable item(s) and sign below. Check the measurement used in Items G8–G10. In Puerto Rico only, enter meters.				
G1. The information in Section C was take engineer, or architect who is authorized data in the Comments area below.)	ed by law to certify eleva	tion information. (Indicate th	ne source and date of the elevation	
G2. A community official completed Section or Zone AO.	-			
G3. The following information (Items G4–	G10) is provided for com	munity floodplain managem	nent purposes.	
G4. Permit Number	G5. Date Permit Issued		Date Certificate of Compliance/Occupancy Issued	
G7. This permit has been issued for:	New Construction S	Substantial Improvement		
G8. Elevation of as-built lowest floor (including of the building:	basement)	fee	t 🔲 meters Datum	
G9. BFE or (in Zone AO) depth of flooding at t	he building site:	fee	t meters Datum	
G10. Community's design flood elevation:		fee	t meters Datum	
Local Official's Name		Title		
Community Name		Telephone		
Signature Date				
Comments (including type of equipment and loc	ation, per C2(e), if applic	cable)		
			Check here if attachments.	

BUILDING PHOTOGRAPHS

ELEVATION CERTIFICATE

See Instructions for Item A6.

OMB No. 1660-0008 Expiration Date: November 30, 2022

IMPORTANT: In these spaces, copy th	FOR INSURANCE COMPANY USE		
Building Street Address (including Apt., Unit, Suite, and/or Bldg. No.) or P.O. Route and Box No. 1790 B1 NM 173			Policy Number:
City	State	ZIP Code	Company NAIC Number
Navajo Dam	New Mexico	87419	

If using the Elevation Certificate to obtain NFIP flood insurance, affix at least 2 building photographs below according to the instructions for Item A6. Identify all photographs with date taken; "Front View" and "Rear View"; and, if required, "Right Side View" and "Left Side View." When applicable, photographs must show the foundation with representative examples of the flood openings or vents, as indicated in Section A8. If submitting more photographs than will fit on this page, use the Continuation Page.



Clear Photo One Photo One Caption

Photo Two

Photo Two


Photo Two Caption Clear Photo Two

BUILDING PHOTOGRAPHS

ELEVATION CERTIFICATE

Continuation Page


IMPORTANT: In these spaces, copy the cor			FOR INSURANCE COMPANY USE
Building Street Address (including Apt., Unit, \$ 1790 B1 NM 173	Suite, and/or Bldg. No.) or P.C). Route and Box No.	Policy Number:
City Navajo Dam	State New Mexico	ZIP Code 87419	Company NAIC Number
If submitting more photographs than will fit with: date taken; "Front View" and "Rear photographs must show the foundation with I	View"; and, if required, "R	ight Side View" and "L	eft Side View." When applicable,
	Photo Thre	e	
	Photo Three		
Photo Three Caption			Clear Photo Three
	Photo Fou	ř	
A STATE OF THE STA	Photo Four		
Photo Four Caption			Clear Photo Four

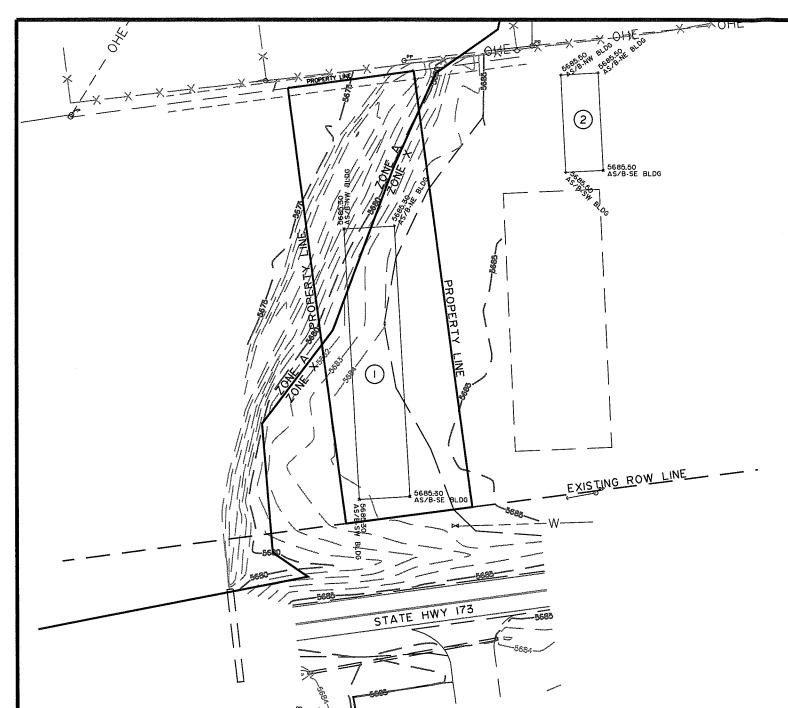

FLOOD ELEVATION CERTIFICATE
FOR
GARRETT CHAVEZ/ABE'S BOAT STORAGE
OF LOT 3, BLOCK TWO
SAN JUAN RIVER ESTATES SUBDIVISION No. 1
No. 1790 B1 NM HWY 173
SAN JUAN COUNTY, NEW MEXICO
NAVAJO DAM, SAN JUAN COUNTY,
NEW MEXICO 87419

KEYED NOTES:

- 1) 5208.00 sf NEW ENCLOSED BOAT STORAGE BUILDING (168'x31') FINISH FLOOR ELEVATION = 5685.30.
- 2 1448.00 sf NEW ENCLOSED BOAT STORAGE BUILDING (24'x60') FINISH FLOOR ELEVATION = 5685.50.

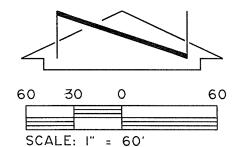

DETERMINED BASE FLOOD ELEVATION


I. DATA FROM PANEL 35045C0800F REVISED AUGUST 5, 2010 IS ZONE A BASE FLOOD ELEVATION OF 5674.85 BASED ON INTERPLOATION OF ELEVATION CERTIFICATE FOR No. 7 ROAD 4267 ON II/12/2007.
2 SEE SHEET No. 2 OF 2 FOR FIRM MAP INFORMATION.







ISSUE DATE: 07/14/2021 PRINTED: July 15, 2021

FILE: D:\DWG-HWS\2020\20260\20260FLDCERTFNL-CON2.dwg

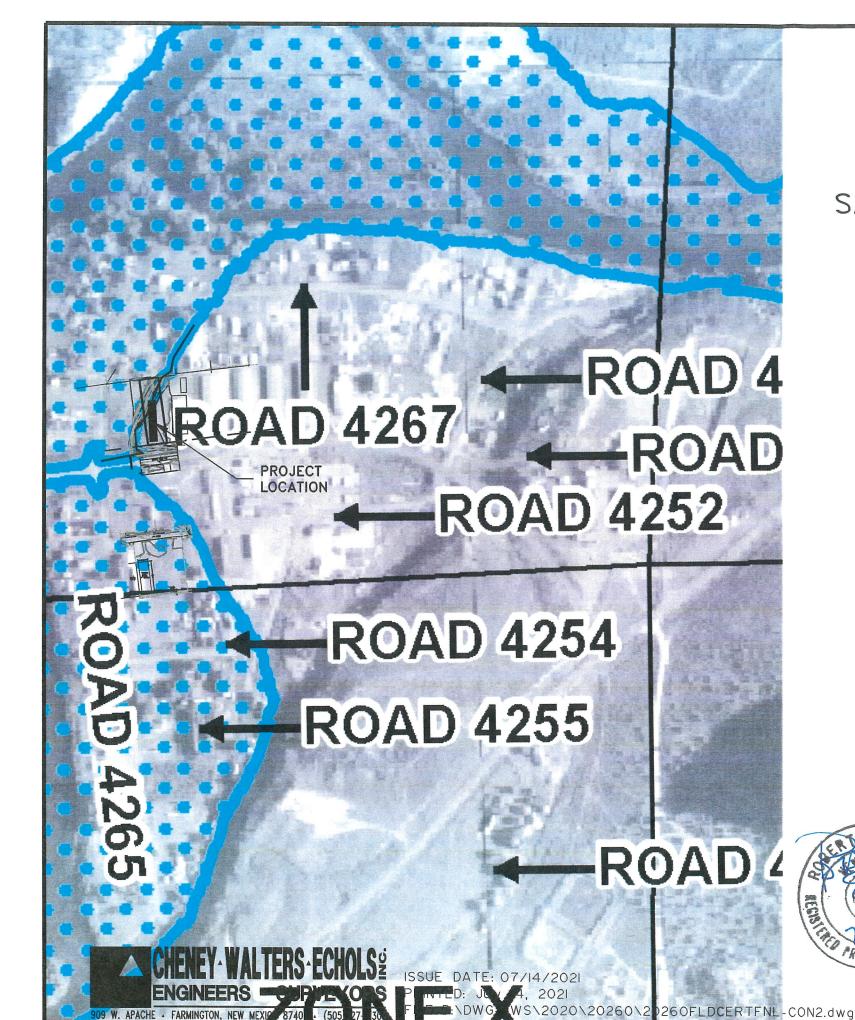

FLOOD ELEVATION CERTIFICATE
FOR
GARRETT CHAVEZ/ABE'S BOAT STORAGE
OF LOT 3, BLOCK TWO
SAN JUAN RIVER ESTATES SUBDIVISION No. 1
No. 1790 B1 NM HWY 173
SAN JUAN COUNTY, NEW MEXICO
NAVAJO DAM, SAN JUAN COUNTY,
NEW MEXICO 87419

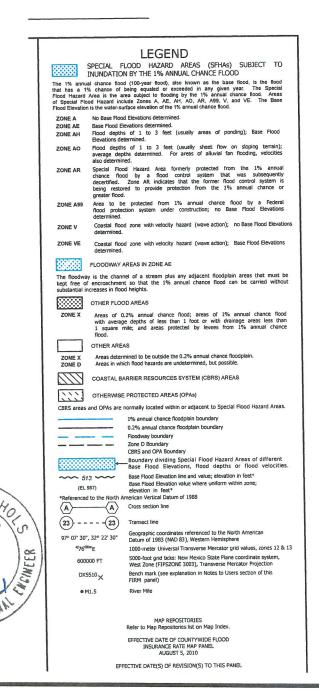

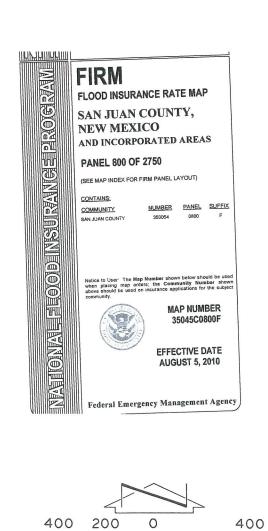

SCALE: I" = 400

SHEET No. 2 OF 2