U.S. DEPARTMENT OF HOMELAND SECURITY Federal Emergency Management Agency

National Flood Insurance Program

OMB No. 1660-0008 Expiration Date: November 30, 2022

ELEVATION CERTIFICATE

Important: Follow the instructions on pages 1-9.

Copy all pages of this Elevation Certificate and all attachments for (1) community official, (2) insurance agent/company, and (3) building owner.

SECTION A - PROPERTY INFORMATION	FC	OR INSURANCE COMPANY USE	
A1. Building Owner's Name		olicy Number:	
Nancy Loya and Julio Aguilesa			
 Building Street Address (including Apt., Unit, Suite, and/or Bldg. No.) or P.O. Route and Box No. Road 5005 		ompany NAIC Number:	
City Stat	e ZI	P Code	
Bloomfield New	Mexico 87	'413	
A3. Property Description (Lot and Block Numbers, Tax Parcel Number R0072154	, Legal Description, etc.)		
A4. Building Use (e.g., Residential, Non-Residential, Addition, Access	ory, etc.) Residential	<u>-</u>	
A5. Latitude/Longitude: Lat. <u>36.702630</u> Long. <u>-107.9971</u>	90 Horizontal Datum:	NAD 1927 ✓ NAD 1983	
A6. Attach at least 2 photographs of the building if the Certificate is be	ing used to obtain flood insuranc	æ.	
A7. Building Diagram Number5_			
A8. For a building with a crawlspace or enclosure(s):			
a) Square footage of crawlspace or enclosure(s)	1842.00 sq ft		
b) Number of permanent flood openings in the crawlspace or encl	osure(s) within 1.0 foot above ad	jacent grade N/A	
c) Total net area of flood openings in A8.b N/A	sq in		
d) Engineered flood openings?			
A9. For a building with an attached garage:			
a) Square footage of attached garage N/A	sq ft		
b) Number of permanent flood openings in the attached garage wi	thin 1.0 foot above adjacent grad	de N/A	
c) Total net area of flood openings in A9.b N/A	A sq in	any many about an industria	
d) Engineered flood openings? Yes No			
a, znameorea need epeninge. The Miner			
SECTION B - FLOOD INSURANCE RATE MAP (FIRM) INFORMATION			
	unty Name	B3. State	
City of Bloomfield/San Juan River San Ju	an	New Mexico	
B4. Map/Panel B5. Suffix B6. FIRM Index B7. FIRM Pane Effective/	Zone(s) (Zor	e Flood Elevation(s) ne AO, use Base Flood Depth)	
70P Revised Da 06-10-2013	06/10/2013 5408.90)	
B10. Indicate the source of the Base Flood Elevation (BFE) data or base flood depth entered in Item B9:			
▼ FIS Profile			
B11. Indicate elevation datum used for BFE in Item B9: NGVD 192	29 X NAVD 1988 Other	r/Source:	
B12. Is the building located in a Coastal Barrier Resources System (CBRS) area or Otherwise Protected Area (OPA)? 🗌 Yes 🔀 No			
Designation Date: CBRS OPA	1		

ELEVATION CERTIFICATE

OMB No. 1660-0008 Expiration Date: November 30, 2022

IMPORTANT: In these spaces, copy the corresponding information from Section A.		FOR INSURANCE COMPANY USE	
Building Street Address (including Apt., Unit, Suite, and/or Bldg. No.) or P.O. Route and Box No. 84 Road 5005		Policy Number:	
City Bloomfield	State ZIP New Mexico 874	Code 13	Company NAIC Number
SECTION C - BU	ILDING ELEVATION INFORMAT	TON (SURVEY RE	EQUIRED)
	Construction Drawings*	ding Under Construing is complete. FE), AR, AR/A, AR/A, Item A7. In Puerto WGS 1984 w. FE.	Check the measurement used. Check the meters N/A
g) Highest adjacent (finished) grade ne	- ' '	5	409.7 X feet meters
h) Lowest adjacent grade at lowest elev structural support	vation of deck or stairs, including	5	409.3 X feet meters
SECTION D - SI	URVEYOR, ENGINEER, OR ARC	CHITECT CERTIFI	CATION
This certification is to be signed and sealed but I certify that the information on this Certificate statement may be punishable by fine or improved the latitude and longitude in Section A proved	e represents my best efforts to inter isonment under 18 U.S. Code, Sec	pret the data availa tion 1001.	law to certify elevation information. ble. I understand that any false Check here if attachments.
Certifier's Name	License Number		
Robert A. Echols, Jr., PE Title President Company Name Cheney-Walters-Echols, Inc. Address 909 W. Apache City Farmington	State New Mexico	ZIP Code 87401	A ECHO SO
Signature	Date	Telephone	Ext.
Copy all pages of this Elevation Certificate and	all attachments for (1) community of	(505) 327-3303	agent/company, and (3) building owner.
Comments (including type of equipment and			and (a) suitaining officer.

ELEVATION CERTIFICATE

OMB No. 1660-0008 Expiration Date: November 30, 2022

			FOR INSURAN	CE COMPANY USE
Building Street Address (including Apt., Unit, Suite, and/or Bldg 84 Road 5005	. No.) or P.O. Route and Box	x No.	Policy Number:	
City State	ZIP Code		Company NAIC	Number
Bloomfield New Mex	rico 87413			
SECTION E – BUILDING ELEVATION INFORMATION (SURVEY NOT REQUIRED) FOR ZONE AO AND ZONE A (WITHOUT BFE)				
For Zones AO and A (without BFE), complete Items E1–E5. If the complete Sections A, B, and C. For Items E1–E4, use natural grenter meters.				
E1. Provide elevation information for the following and check the appropriate boxes to show whether the elevation is above or below the highest adjacent grade (HAG) and the lowest adjacent grade (LAG).a) Top of bottom floor (including basement,				above or below
crawlspace, or enclosure) is	feet	meters meters	above or	below the HAG.
b) Top of bottom floor (including basement, crawlspace, or enclosure) is	feet	meters	above or	below the LAG.
E2. For Building Diagrams 6–9 with permanent flood openings	provided in Section A Items	8 and/or 9	(see pages 1–2	2 of Instructions),
the next higher floor (elevation C2.b in the diagrams) of the building is		meters	above or	below the HAG.
E3. Attached garage (top of slab) is	feet	meters	above or	below the HAG.
E4. Top of platform of machinery and/or equipment servicing the building is		☐ meters	☐ above or	below the HAG.
E5. Zone AO only: If no flood depth number is available, is the floodplain management ordinance? Yes No				
SECTION F - PROPERTY OWNER (OF	OWNER'S REPRESENTA	TIVE) CE	RTIFICATION	
The property owner or owner's authorized representative who c	····	· · · · · · · · · · · · · · · · · · ·		EMA issued or
community-issued BFE) or Zone AO must sign here. The staten	nents in Sections A, B, and I	E are corre	ect to the best of	f my knowledge.
Property Owner or Owner's Authorized Representative's Name Robert A. Echols, Jr., PE				
Address 909 W. Apache	City Farmington	Star Nev	te v Mexico	ZIP Code 87401
Signature	Date		ephone 5) 327-3303	
Comments				
			Check h	nere if attachments.

ELEVATION CERTIFICATE

OMB No. 1660-0008 Expiration Date: November 30, 2022

IMPORTANT: In these spaces, copy the corresponding information from Section A.			FOR INSURANCE COMPANY USE	
84 Road 5005			Policy Number:	
City Bloomfield	State ZIP Code New Mexico 87413		Company NAIC Number	
SECTION G	G - COMMUNITY INFORMATION (O	PTIONAL)		
The local official who is authorized by law or ordinance to administer the community's floodplain management ordinance can complete Sections A, B, C (or E), and G of this Elevation Certificate. Complete the applicable item(s) and sign below. Check the measurement used in Items G8–G10. In Puerto Rico only, enter meters.				
G1. The information in Section C was taken fr engineer, or architect who is authorized b data in the Comments area below.)	engineer, or architect who is authorized by law to certify elevation information. (Indicate the source and date of the elevation			
G2. A community official completed Section E or Zone AO.	E for a building located in Zone A (with	hout a FEMA	-issued or community-issued BFE)	
G3. The following information (Items G4–G10)) is provided for community floodplain	n manageme	nt purposes.	
G4. Permit Number G5	5. Date Permit Issued		ate Certificate of ompliance/Occupancy Issued	
G7. This permit has been issued for:	ew Construction 🔲 Substantial Impro	ovement		
G8. Elevation of as-built lowest floor (including bas of the building:	sement)	feet	meters Datum	
G9. BFE or (in Zone AO) depth of flooding at the b	building site:	feet	meters Datum	
G10. Community's design flood elevation:	·	feet	meters Datum	
Local Official's Name	Title			
Community Name	Telephone			
Signature	Date			
Comments (including type of equipment and location, per C2(e), if applicable)				
			Check here if attachments.	

BUILDING PHOTOGRAPHS

ELEVATION CERTIFICATE

See Instructions for Item A6.

OMB No. 1660-0008 Expiration Date: November 30, 2022

IMPORTANT: In these spaces, copy the corresponding information from Section A.		FOR INSURANCE COMPANY USE	
Building Street Address (including Apt., Unit, Suite, and/or Bldg. No.) or P.O. Route and Box No.		Policy Number:	
84 Road 5005			
City	State	ZIP Code	Company NAIC Number
Bloomfield	New Mexico	87413	

If using the Elevation Certificate to obtain NFIP flood insurance, affix at least 2 building photographs below according to the instructions for Item A6. Identify all photographs with date taken; "Front View" and "Rear View"; and, if required, "Right Side View" and "Left Side View." When applicable, photographs must show the foundation with representative examples of the flood openings or vents, as indicated in Section A8. If submitting more photographs than will fit on this page, use the Continuation Page.

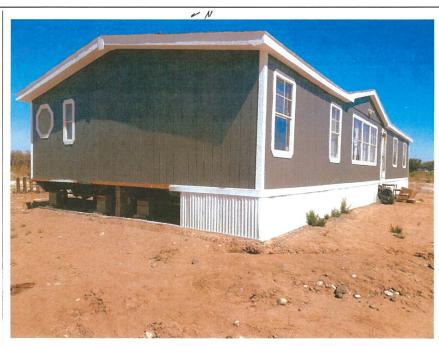


Photo One

Photo One Caption Clear Photo One

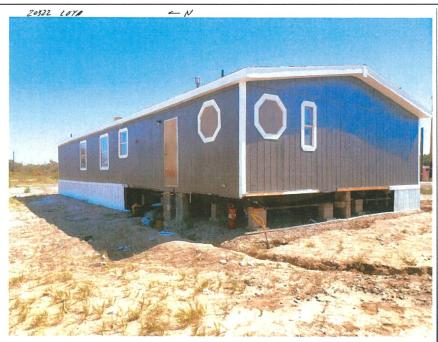


Photo Two

Photo Two Caption Clear Photo Two

BUILDING PHOTOGRAPHS

ELEVATION CERTIFICATE

Continuation Page

OMB No. 1660-0008 Expiration Date: November 30, 2022

IMPORTANT: In these spaces, copy the corresponding information from Section A.		FOR INSURANCE COMPANY USE	
Building Street Address (including Apt., Unit, Suite, and/or Bldg. No.) or P.O. Route and Box No. 84 Road 5005		Policy Number:	
City Bloomfield	State New Mexico	ZIP Code 87413	Company NAIC Number

If submitting more photographs than will fit on the preceding page, affix the additional photographs below. Identify all photographs with: date taken; "Front View" and "Rear View"; and, if required, "Right Side View" and "Left Side View." When applicable, photographs must show the foundation with representative examples of the flood openings or vents, as indicated in Section A8.


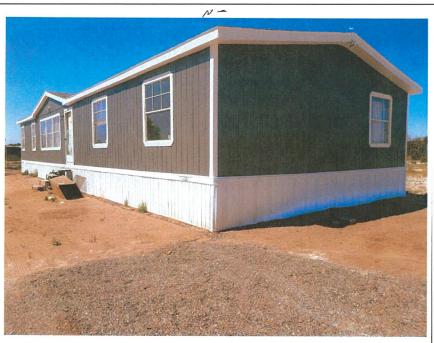


Photo Three

Photo Three Caption Clear Photo Three

Photo Four

Photo Four Caption Clear Photo Four

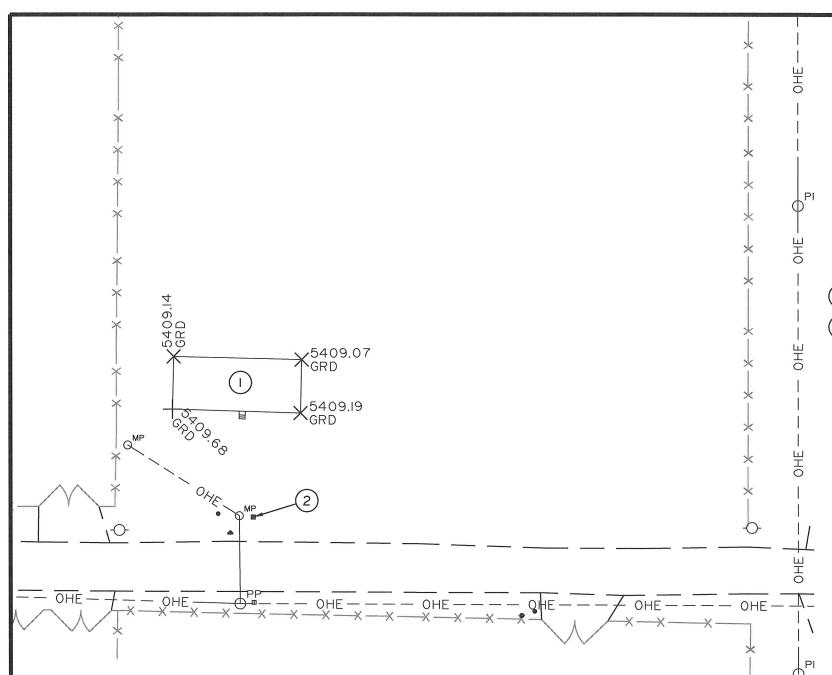

FLOOD ELEVATION CERTIFICATE
84 ROAD 5005
BLOOMFIELD, NEW MEXICO 87413
FOR
NANCY LOYA AND JULIO AGUILESA

KEYED NOTES:

- 1 1842.0' DOUBLE WIDE LOCATION FINISH FLOOR ELEVATION = 5413.00.
- (2) EXISTING NATUAL GAS RISER.


NOTES:

- I.) SEPTIC SYSTEM IS NOT INSTALLED AS OF DATE OF SURVEY 09/15/2021.
- 2.) ELECTRIC, GAS AND WATER ARE NOT INSTALLED AS OF DATE OF SURVEY 09/15/2021.
- 3.) AIR CONDITION UNIT IS ROOF MOUNTED.

DETERMINED BASE FLOOD ELEVATION

I. DATA FROM PANEL 35045CI055F REVISED JUNE 10, 2013 LOMR IS ZONE A SEE SHEET No. 2 OF 3 FOR FIRM MAP INFORMATION.

2. SEE SHEET No. 3 OF 3 FOR SAN JUAN RIVER FLOOD PROFILE DRAWING 70P FROM LOMR EFFECTIVE 06/10/2013. - BASE FLOOD ELEVATION = 5408.90.

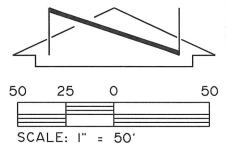






ISSUE DATE: 09/16/2021
PRINTED: September 16, 2021
FILE: D. DWG-HWS 2020 2022

FILE: D:\DWG-HWS\2020\20232\20232FLDCERTFNL-091621.dwg

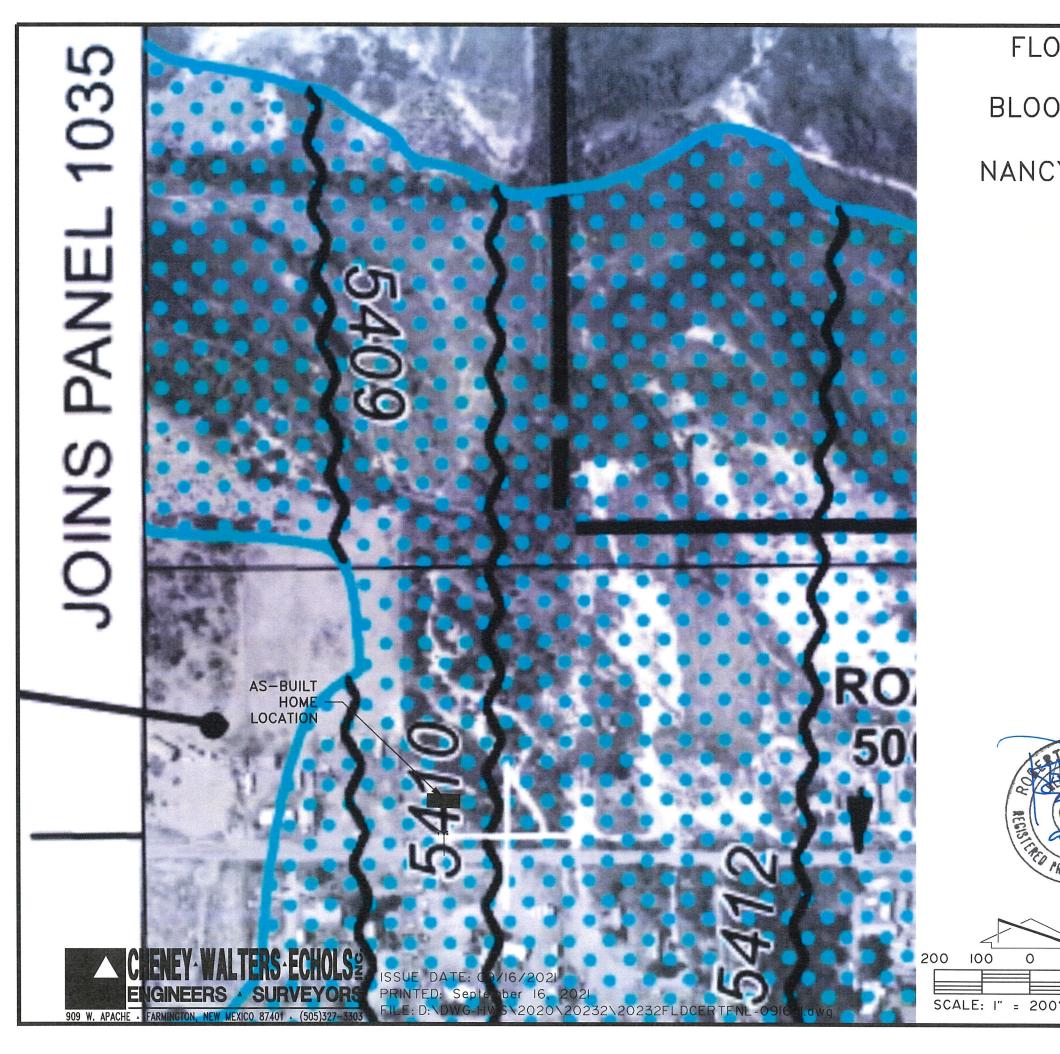


FLOOD ELEVATION CERTIFICATE


84 ROAD 5005

BLOOMFIELD, NEW MEXICO 87413

FOR

NANCY LOYA AND JULIO AGUILESA

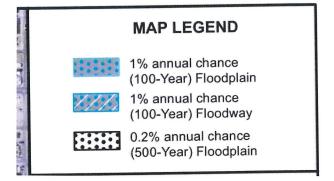

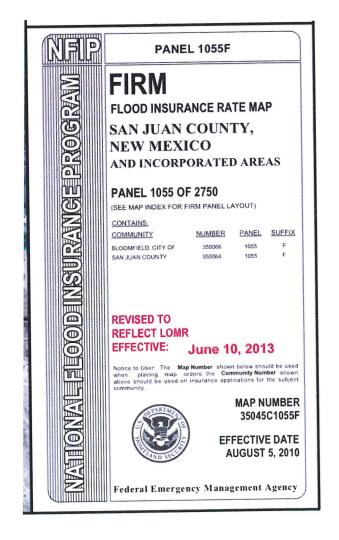

SHEET No. 2 OF 3

200


FLOOD ELEVATION CERTIFICATE

84 ROAD 5005

BLOOMFIELD, NEW MEXICO 87413

FOR

NANCY LOYA AND JULIO AGUILESA

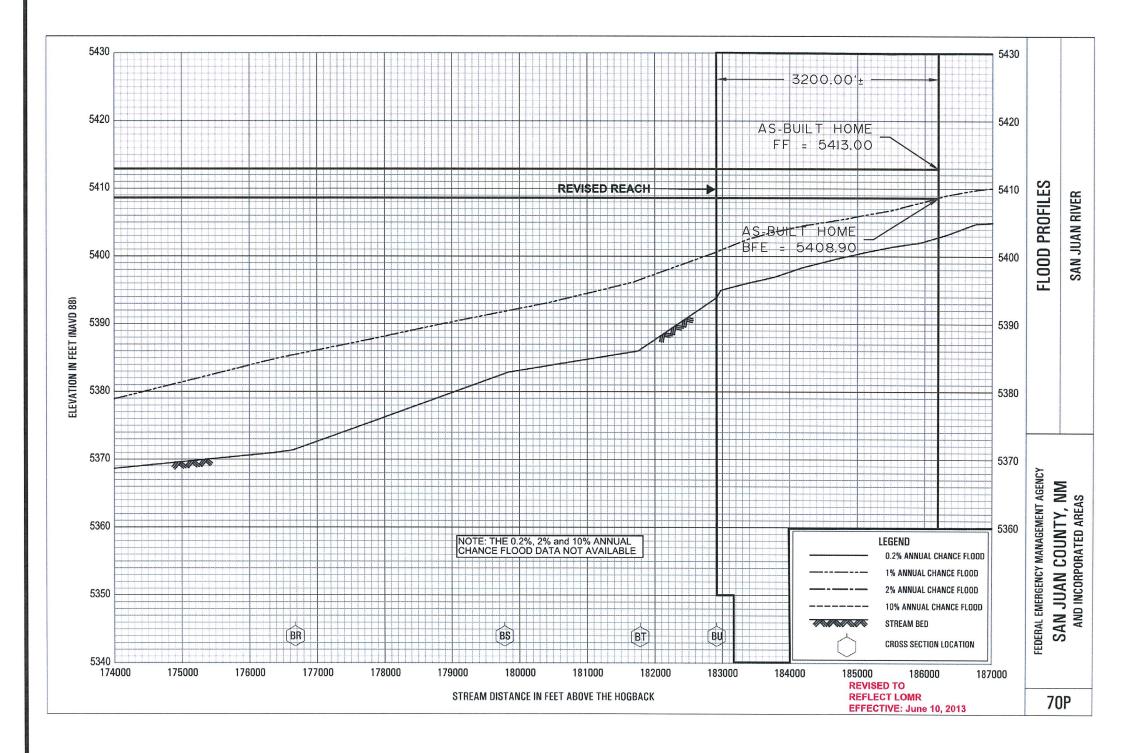





ISSUE DATE: 09/16/2021
PRINTED: September 16, 2021
FILE: D:\DWG-HWS\2020\20232\20232FLDCERTFNL-091621.dwg