U.S. DEPARTMENT OF HOMELAND SECURITY Federal Emergency Management Agency

National Flood Insurance Program

OMB No. 1660-0008

Expiration Date: November 30, 2022

ELEVATION CERTIFICATE

Important: Follow the instructions on pages 1-9.

Copy all pages of this Elevation Certificate and all attachments for (1) community official, (2) insurance agent/company, and (3) building owner.

				FOR INSUF	RANCE COMPANY USE	
A1. Building Owner's Name Tyler Boatwright					Policy Numl	ber:
A2. Building Street Address (including Apt., Unit, Suite, and/or Bldg. No.) or P.O. Route and				Company N	IAIC Number:	
Box No. 1003 S. Church St.				, ,		
City			State		ZIP Code	
Bloomfield			New Me		87413	
A3. Property Description (Lo Tract 2 Luna Subdivision	ot and Block Numbers, Ta	x Parcel	Number, Leg	gal Description, etc	0.)	
A4. Building Use (e.g., Resi	dential, Non-Residential, /	Addition	, Accessory, e	etc.) Residentia	al	
A5. Latitude/Longitude: La	i. 36.703350	Long1	07.993470	Horizonta	Datum: NAD 1	1927 × NAD 1983
A6. Attach at least 2 photog	raphs of the building if the	e Certific	ate is being ι	sed to obtain floor	d insurance.	
A7. Building Diagram Numb	er2A					
A8. For a building with a cra	wispace or enclosure(s):					
a) Square footage of cr	awispace or enclosure(s)		2	2175.00 sq ft		
b) Number of permaner	t flood openings in the cra	awlspace	e or enclosure	e(s) within 1.0 foot	above adjacent gra	ade 13
c) Total net area of floo	d openings in A8.b	1	664.00 sq in	ı		
d) Engineered flood ope						
A9. For a building with an att	ached garage:					
a) Square footage of att	ached garage		N/A sq ft			
b) Number of permanen	t flood openings in the att	ached g	arage within	1.0 foot above adi	acent grade	
b) Number of permanent flood openings in the attached garage within 1.0 foot above adjacent grade c) Total net area of flood openings in A9.b sq in						
d) Engineered flood openings? Yes No						
SECTION B - FLOOD INSURANCE RATE MAP (FIRM) INFORMATION						
B1. NFIP Community Name	& Community Number		B2. County	Name		B3. State
City of Bloomfield 350066			San Juan			New Mexico
B4. Map/Panel B5. Suff	B6. FIRM Index Date	Effe	RM Panel ective/ vised Date	B8. Flood Zone(s)	B9. Base Flood E (Zone AO, use	levation(s) e Base Flood Depth)
35045C1055F F	08-05-2010	08-05-2		AE	5413.7	
B10. Indicate the source of the Base Flood Elevation (BFE) data or base flood depth entered in Item B9:						
FIS Profile FIRM Community Determined Other/Source:						
B11. Indicate elevation datu	m used for BFE in Item B	9: 🗌 N	GVD 1929	X NAVD 1988	Other/Source:	
B12. Is the building located in a Coastal Barrier Resources System (CBRS) area or Otherwise Protected Area (OPA)? 🗌 Yes 🗵 No						
Designation Date: CBRS DPA						

ELEVATION CERTIFICATE

OMB No. 1660-0008 Expiration Date: November 30, 2022

IMPORTANT: In these spaces, copy the corresponding information from Section A.	FOR INSURANCE COMPANY USE	
Building Street Address (including Apt., Unit, Suite, and/or Bldg. No.) or P.O. Route and Box No. 1003 S. Church St.	Policy Number:	
City State ZIP Code Bloomfield New Mexico 87413	Company NAIC Number	
SECTION C – BUILDING ELEVATION INFORMATION (SURVEY R	EQUIRED)	
C1. Building elevations are based on: Construction Drawings* Building Under Construction Provided Pro	ruction* Finished Construction	
<u> </u>	5415.9 X leet Meters	
h) Lowest adjacent grade at lowest elevation of deck or stairs, including structural support	5415.8 X feet meters	
SECTION D – SURVEYOR, ENGINEER, OR ARCHITECT CERTIF	FICATION	
This certification is to be signed and sealed by a land surveyor, engineer, or architect authorized by a land surveyor in the information on this Certificate represents my best efforts to interpret the data available statement may be punishable by fine or imprisonment under 18 U.S. Code, Section 1001. Were latitude and longitude in Section A provided by a licensed land surveyor?	by law to certify elevation information. able. I understand that any false Check here if attachments.	
Certifier's Name License Number		
Robert A. Echols, Jr., PE 6580 Title President Company Name Cheney-Walters-Echols, Inc. Address 909 W. Apache City Farmington State New Mexico 87401	POFESSIONAL TO SOLUTION AND PESSIONAL TO SOL	
Signature Date Telephone (505) 327-3303	Ext.	
Copy all pages of this Elevation Certificate and all attachments for (1) community official, (2) insurance	e agent/company, and (3) building owner	
Comments (including type of equipment and location, per C2(e), if applicable) C2.e Hot Water Heater	s agos company, and (c) building owner.	

ELEVATION CERTIFICATE

OMB No. 1660-0008 Expiration Date: November 30, 2022

IMPORTANT: In these spaces, copy the corresponding information from Section A. FOR INSURANCE COMPAN	Y USE
Building Street Address (including Apt., Unit, Suite, and/or Bldg. No.) or P.O. Route and Box No. Policy Number:	
City State ZIP Code Company NAIC Number Bloomfield New Mexico 87413	
SECTION E – BUILDING ELEVATION INFORMATION (SURVEY NOT REQUIRED) FOR ZONE AO AND ZONE A (WITHOUT BFE)	
For Zones AO and A (without BFE), complete Items E1–E5. If the Certificate is intended to support a LOMA or LOMR-F request, complete Sections A, B,and C. For Items E1–E4, use natural grade, if available. Check the measurement used. In Puerto Rico only enter meters.	
E1. Provide elevation information for the following and check the appropriate boxes to show whether the elevation is above or belo the highest adjacent grade (HAG) and the lowest adjacent grade (LAG).a) Top of bottom floor (including basement,)W
crawlspace, or enclosure) is	HAG.
crawlspace, or enclosure) is	
the next higher floor (elevation C2.b in the diagrams) of the building is feet _ meters _ above or _ below the	
E3. Attached garage (top of slab) is feet meters above or below the	HAG.
E4. Top of platform of machinery and/or equipment servicing the building is feet meters above or below the	HAG.
E5. Zone AO only: If no flood depth number is available, is the top of the bottom floor elevated in accordance with the community's floodplain management ordinance? Yes No Unknown. The local official must certify this information in Section	
SECTION F - PROPERTY OWNER (OR OWNER'S REPRESENTATIVE) CERTIFICATION	
The property owner or owner's authorized representative who completes Sections A, B, and E for Zone A (without a FEMA-issued community-issued BFE) or Zone AO must sign here. The statements in Sections A, B, and E are correct to the best of my knowledge.	or ge.
Property Owner or Owner's Authorized Representative's Name Robert A. Echols, Jr., PE	
Address City State ZIP Code 909 W. Apache Farmington New Mexico 87401	
Signature Date Telephone	
211/12 (505) 327-3303	
Comments	

ELEVATION CERTIFICATE

OMB No. 1660-0008 Expiration Date: November 30, 2022

IMPORTANT: In these spaces, copy the corre	FOR INSURANCE COMPANY USE		
Building Street Address (including Apt., Unit, St. 1003 S. Church St.	Box No.	Policy Number:	
City Bloomfield	State ZIP Code New Mexico 87413		Company NAIC Number
SECTION	ON G - COMMUNITY INFORMATION (C	PTIONAL)	
The local official who is authorized by law or or Sections A, B, C (or E), and G of this Elevation used in Items G8–G10. In Puerto Rico only, en	Certificate. Complete the applicable iten		
	en from other documentation that has be ed by law to certify elevation information		
G2. A community official completed Section Zone AO.	ion E for a building located in Zone A (wit	thout a FEMA	-issued or community-issued BFE)
G3. The following information (Items G4-	G10) is provided for community floodpla	in manageme	nt purposes.
G4. Permit Number	G5. Date Permit Issued		ate Certificate of ompliance/Occupancy Issued
G7. This permit has been issued for:]New Construction ☐ Substantial Impr	ovement	
G8. Elevation of as-built lowest floor (including of the building:	g basement) 	_ feet	meters Datum
G9. BFE or (in Zone AO) depth of flooding at	the building site:	feet	meters Datum
G10. Community's design flood elevation:		_ feet	meters Datum
Local Official's Name	Title		
Community Name	Telephone		
Signature	Date		
Comments (including type of equipment and lo	cation, per C2(e), if applicable)		
			☐ Check here if attachments.
			Chock hore is attachments.

BUILDING PHOTOGRAPHS

ELEVATION CERTIFICATE

See Instructions for Item A6.

OMB No. 1660-0008

Expiration Date: November 30, 2022

IMPORTANT: In these spaces, copy the c	FOR INSURANCE COMPANY USE		
Building Street Address (including Apt., Unit	Policy Number:		
1003 S. Church St.			
City	State	ZIP Code	Company NAIC Number
Bloomfield	New Mexico	87413	

If using the Elevation Certificate to obtain NFIP flood insurance, affix at least 2 building photographs below according to the instructions for Item A6. Identify all photographs with date taken; "Front View" and "Rear View"; and, if required, "Right Side View" and "Left Side View." When applicable, photographs must show the foundation with representative examples of the flood openings or vents, as indicated in Section A8. If submitting more photographs than will fit on this page, use the Continuation Page.



Photo One

Photo One Caption Clear Photo One

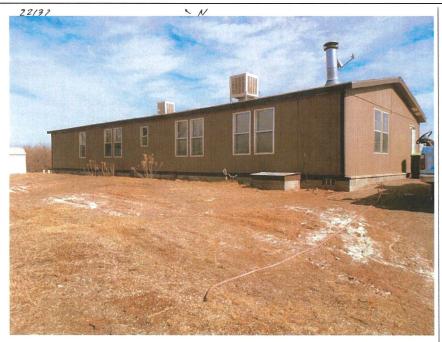


Photo Two

Photo Two Caption

Clear Photo Two

BUILDING PHOTOGRAPHS

ELEVATION CERTIFICATE

Continuation Page

OMB No. 1660-0008 Expiration Date: November 30, 2022

IMPORTANT: In these spaces, copy the	FOR INSURANCE COMPANY USE		
Building Street Address (including Apt., 1003 S. Church St.	Unit, Suite, and/or Bldg. No.) or	P.O. Route and Box No.	Policy Number:
City Bloomfield	State New Mexico	ZIP Code 87413	Company NAIC Number

If submitting more photographs than will fit on the preceding page, affix the additional photographs below. Identify all photographs with: date taken; "Front View" and "Rear View"; and, if required, "Right Side View" and "Left Side View." When applicable, photographs must show the foundation with representative examples of the flood openings or vents, as indicated in Section A8.

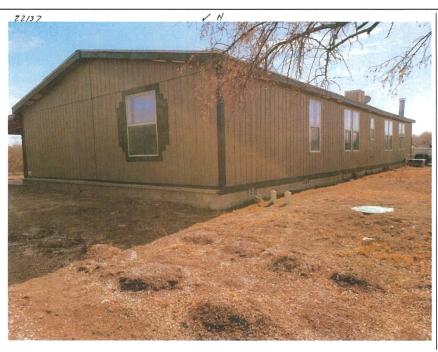


Photo Three

Photo Three Caption

Clear Photo Three


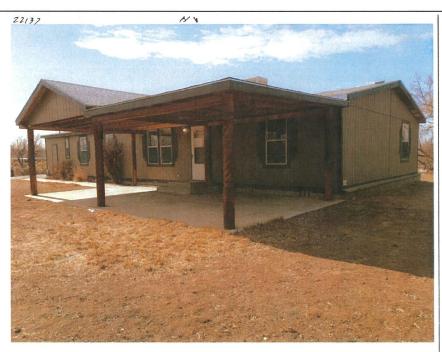


Photo Four Caption

Clear Photo Four Form Page 6 of 6

DETERMINED BASE FLOOD ELEVATION

- I. DATA FROM PANEL 35045CI055F REVISED AUGUST 5, 2010 IS ZONE "AE" WITH A DETERMINED BASE FLOOD ELEVATION = 5413.70.
- 2. SEE SHEET No. 2 OF 3 FOR FIRM MAP INFORMATION.
- 3. SEE SHEET No. 3 OF 3 FOR REVISED MAP INFORMATION DATED 06/10/2013.

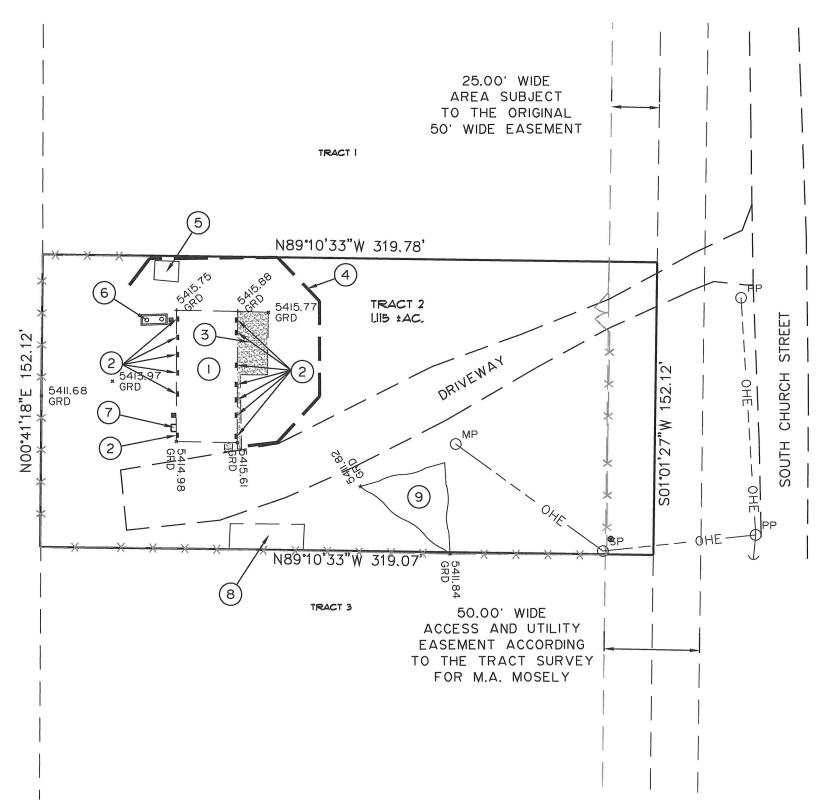


FLOOD ELEVATION CERTIFICATE
1003 SOUTH CHURCH STREET
BLOOMFIELD, NEW MEXICO
TRACT 2 LUNA SUBDIVISION
SAN JUAN COUNTY,
BLOOMFIELD, NEW MEXICO 87413
FOR TYLER BOATWRIGHT

KEYED NOTES:

- 2175.0 sf DOUBLE WIDE RESIDENCE. FINISH FLOOR ELEVATION = 5417.50.
- 2 13 EACH CRAWL SPACE FREE AIR VENTS INVERT ELEVATION = 5416.25.
- (3) COVERED PORCH.
- (4) RAILROAD TIE LANDSCAPE WALL.
- (5) PORTABLE SHED.
- (6) SEPTIC TANK ACCESS ELV = 5415.62.
- 7 CRAWL SPACE ACCESS TOP ELV = 5416.83. BOTTOM ELEVATION = 5413.43.
- (8) DOG KENNEL.
- (9) EXISTING POND TOP WL = 5411.84.

NOTE:


I.) TOTAL NET AREA OF FLOOD OPENING (HOME) = 1664 sq. in.

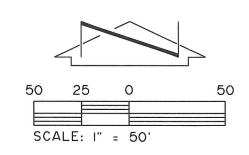





ISSUE DATE: 02/21/2022
PRINTED: February 21, 2022

909 W. APACHE + FARMINGTON, NEW MEXICO 87401 + (505)327-3303 FILE: D:\DWG-HWS\2022\22137\22137 FLDCERT-021622.dwg

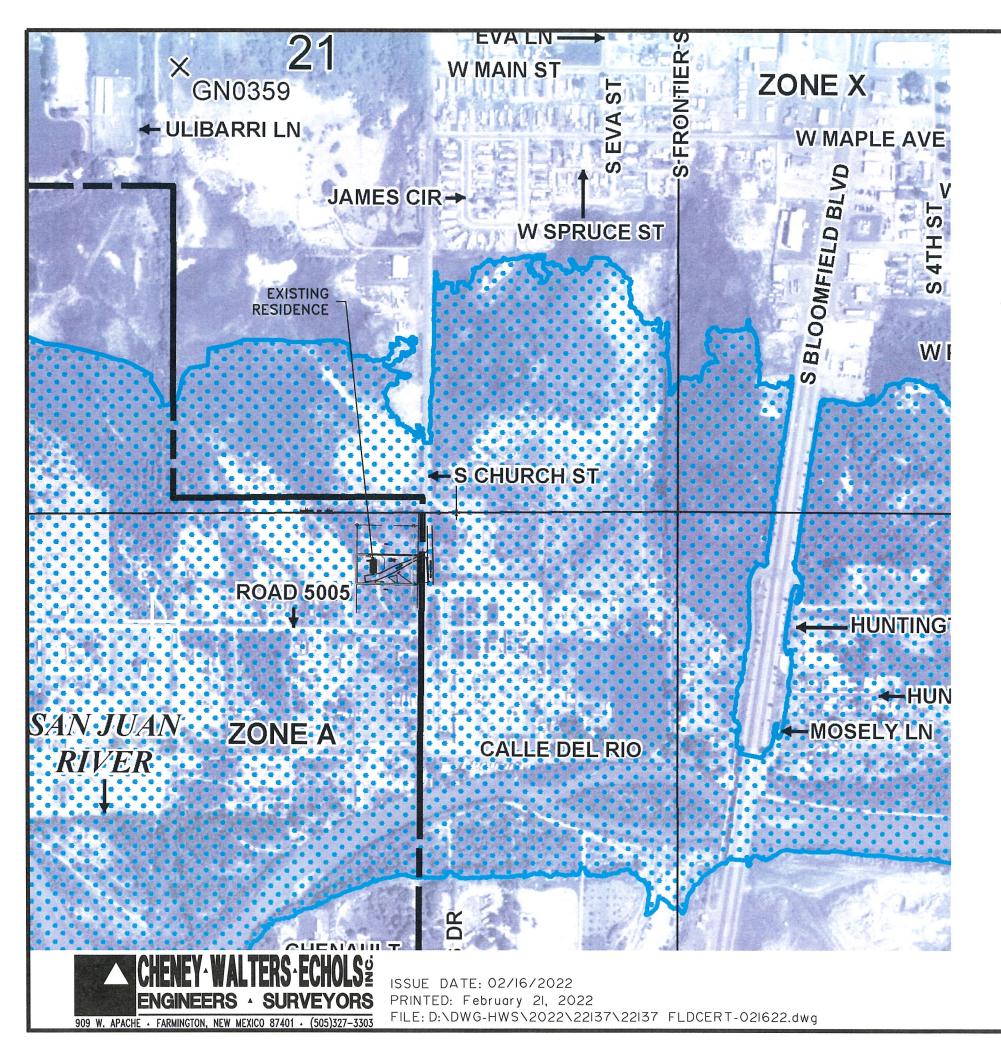


FLOOD ELEVATION CERTIFICATE
1003 SOUTH CHURCH STREET
BLOOMFIELD, NEW MEXICO
TRACT 2 LUNA SUBDIVISION
SAN JUAN COUNTY,
BLOOMFIELD, NEW MEXICO 87413
FOR TYLER BOATWRIGHT

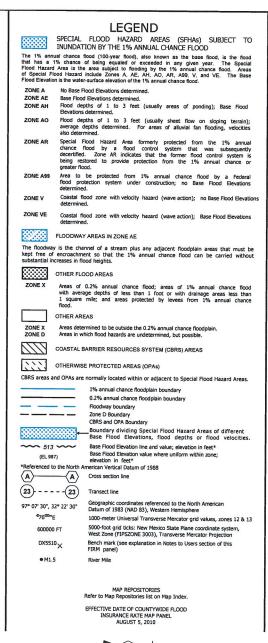

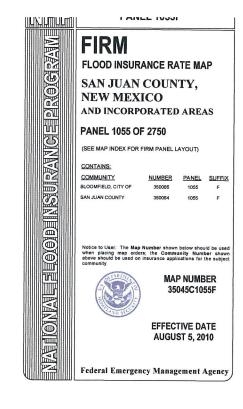



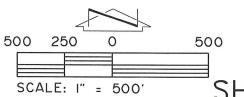

SHEET No. 2 OF 3

National Flood Hazard Layer FIRMette **E** FEMA Legend SEE FE REPORT FOR DETAILED LEGEND AND INDEX MAP FOR FIRM PAR ELLSWOAT Without Bess Flood Benedian (BFE) WAS BEEn Depth Land AS AS AS AS SPECIAL FLOOD HAZARDAREAS 0.2% Ar rivel Charco Florid Helend, Arces of 1% arm of chance flood with over age. Capitile 26 that are follower with Craine 26 areas of less than one sovere mile says A Four Conditions 114 Annual Charte Florid Hazard Zow J. Area with Reduced Floor Risk due on Level. See Need 1200 1 T23N R11W 521 OTHER AREAS OF Area with Flood Rick due to bevere Lamb FLOOD HAZARD AREA OF MINIMAL FLOOD HAZARD. NOSCHEEN Area of Warehall Road Hazard Love I. Byeche to Mas OTHERAREAS Area of Lineau reviews Roses Nauges Laure ---- Charatel, Outvers, or Sount's Se wer City of Bloomfield STRUGTURES | | | | | Levee, Dike, or Rosswell 350066 202 Cross Sections with the Annual Charece 175 Water Surface Bergiter — — Crossol Transco. LOMR-12-08-0882P = Limit of Sway eff. 6/10/2013 Jurisaica in Abautaan Coesial Transco, Basidino OTHER Profile Baseline FEATURES. Hydrographic Feature eff. 8/5/2010 San Juan County Digital Data Available 350064 Na Digital Data Availab MAP PANEIS The directions on the media en executions a pain. Science By the user and does not regress no 120N R11W 528 ert exclaine inciproperty lace int. This map complies with FEMA's standards for the use of digital flood maps if it is not raid as described below: The besome pishown complies with FEMA's become p The floor hazaro informacion is derived directly from the as deminative NFM1 web services provided by FEMA. This map we's expense of 12/21/2021 or 10:17 AM and decire. reflect their ges or emotionicities subsect on the this developed time. The MFML and effective information may change as Be come superseded by new data ever time. This map image is vaid if the are a mare of the following map clamaris de recepções: besames imagary, des quara labels, legano, scale bas, map oceaiem oake, cammuniky identificas, FIRM panel number, and FIRM effective date. Mapimages for 10 7736 18 W 20741 38 PH 1:6,000 regulatory purpases. 250 1,000 1,500 Basemap: USGS National Map: Ortholmagery: Data refreshed October, 2020

FLOOD ELEVATION CERTIFICATE
1003 SOUTH CHURCH STREET
BLOOMFIELD, NEW MEXICO
TRACT 2 LUNA SUBDIVISION
SAN JUAN COUNTY,
BLOOMFIELD, NEW MEXICO 87413
FOR TYLER BOATWRIGHT





ISSUE DATE: 02/16/2022 PRINTED: February 21, 2022

FILE: D:\DWG-HWS\2022\22137\22137 FLDCERT-021622.dwg