U.S. DEPARTMENT OF HOMELAND SECURITY

Federal Emergency Management Agency National Flood Insurance Program

OMB No. 1660-0008 Expiration Date: November 30, 2022

ELEVATION CERTIFICATE

Important: Follow the instructions on pages 1–9.

Copy all pages of this Elevation Certificate and all attachments for (1) community official, (2) insurance agent/company, and (3) building owner.

SECTION A - PROPERTY INFORMATION					FOR INSUF	RANCE COMPANY USE
A1. Building Owner's Name Bennie Aragon				Policy Num	oer:	
A2. Building Street Address (including Apt., Unit, Suite, and/or Bldg. No.) or P.O. Route and Box No. 27 Road 5777				Company N	AIC Number:	
City Farmington				ZIP Code 87401		
A3. Property Description (Lot a Lot 10 Block 10 Wild Horse Va		x Parcel	Number, Leç	gal Description, etc	c.)	
A4. Building Use (e.g., Reside	ntial, Non-Residential,	Addition,	, Accessory, e	etc.) Residentia	l	
A5. Latitude/Longitude: Lat.	N 36° 42' 12"	Long. W	/108° 07' 38"	Horizontal	Datum: NAD 1	927 X NAD 1983
A6. Attach at least 2 photogra	phs of the building if the	e Certific	ate is being u	sed to obtain floor	d insurance.	
A7. Building Diagram Number	8					
A8. For a building with a crawl	space or enclosure(s):					
a) Square footage of craw	vispace or enclosure(s)		1	218.00 sq ft		
b) Number of permanent f	lood openings in the cra	awlspace	e or enclosure	e(s) within 1.0 foot	above adjacent gra	ade 0
c) Total net area of flood of	ppenings in A8.b		N/A sq in			
d) Engineered flood open	ings? Yes X N	10				
A9. For a building with an attac	ched garage:					
a) Square footage of attac	hed garage		N/A sq ft			
b) Number of permanent flood openings in the attached garage within 1.0 foot above adjacent grade N/A						
c) Total net area of flood openings in A9.b N/A sq in						
d) Engineered flood openings? ☐ Yes ☒ No						
a, Engineered need openings.						
SECTION B - FLOOD INSURANCE RATE MAP (FIRM) INFORMATION						
B1. NFIP Community Name & Community Number San Juan County 350046		B2. County Name San Juan			B3. State New Mexico	
B4. Map/Panel B5. Suffix Number	B6. FIRM Index Date	Effe	L RM Panel ective/	B8. Flood Zone(s)	B9. Base Flood E (Zone AO, us	 levation(s) e Base Flood Depth)
35045C1010F F	08-05-2010	Rev 08-05-2	vised Date 2010	AE	5313.0	
B10. Indicate the source of the Base Flood Elevation (BFE) data or base flood depth entered in Item B9:						
☐ FIS Profile ☐ FIRM ☐ Community Determined ☒ Other/Source: San Juan County River Sheet 67P						
B11. Indicate elevation datum used for BFE in Item B9: NGVD 1929 NAVD 1988 Other/Source:						
B12. Is the building located in a Coastal Barrier Resources System (CBRS) area or Otherwise Protected Area (OPA)? 🗌 Yes 🔀 No						
Designation Date: CBRS OPA						

ELEVATION CERTIFICATE

IMPORTANT: In these spaces, copy the corresponding information from Section A.			FOR INSURANCE COMPANY USE		
Building Street Address (including Apt., Unit, Suite, and 27 Road 5777	Policy Number:				
	State ZIP New Mexico 8740	Code)1	Company NAIC Number		
SECTION C - BUILDING	ELEVATION INFORMAT	TON (SURVEY RE	QUIRED)		
C1. Building elevations are based on: Construction *A new Elevation Certificate will be required when C2. Elevations – Zones A1–A30, AE, AH, A (with BFI Complete Items C2.a–h below according to the benchmark Utilized: WGS 1984 Indicate elevation datum used for the elevations in NGVD 1929 NAVD 1988 Other Datum used for building elevations must be the set a) Top of bottom floor (including basement, craw b) Top of the next higher floor c) Bottom of the lowest horizontal structural mend d) Attached garage (top of slab) e) Lowest elevation of machinery or equipment so (Describe type of equipment and location in C) to build the control of the lowest adjacent (finished) grade next to build the control of the lowest adjacent (finished) grade next to build the control of the lowest adjace	ction Drawings*	ding Under Construction is complete. FE), AR, AR/A, AR/A, Item A7. In Puerto WGS 1984 W. FE. 5. 5. 5.	ction*		
g) Highest adjacent (finished) grade next to buildh) Lowest adjacent grade at lowest elevation of a		5	315.1 X feet meters		
structural support	deck of stalls, including	5	314.5 X feet meters		
SECTION D – SURVEYOR, ENGINEER, OR ARCHITECT CERTIFICATION This certification is to be signed and sealed by a land surveyor, engineer, or architect authorized by law to certify elevation information. I certify that the information on this Certificate represents my best efforts to interpret the data available. I understand that any false statement may be punishable by fine or imprisonment under 18 U.S. Code, Section 1001. Were latitude and longitude in Section A provided by a licensed land surveyor? Yes No Check here if attachments.					
Certifier's Name Robert A. Echols, Jr., PE Title President Company Name Cheney-Walters-Echols, Inc. Address 909 W. Apache City Farmington	License Number 6580 State New Mexico	ZIP Code 87401	A. F.C.HOO. S. O.		
Signature	Date 1/13/2023	Telephone (505) 327-3303	Ext.		
Copy all pages of this Elevation Certificate and all attachments for (1) community official, (2) insurance agent/company, and (3) building owner.					
Comments (including type of equipment and location, Roof top air unit elevation 5325					

ELEVATION CERTIFICATE

IMPORTANT: In these spaces, copy the corresponding	FOR INSURANCE COMPAN	NY USE			
Building Street Address (including Apt., Unit, Suite, and/o 27 Road 5777	or Bldg. No.) or P.O. R	oute and Box No.	Policy Number:		
		P Code 7401	Company NAIC Number		
SECTION E – BUILDING ELE FOR ZONE A	VATION INFORMAT AO AND ZONE A (W		REQUIRED)		
For Zones AO and A (without BFE), complete Items E1–E5. If the Certificate is intended to support a LOMA or LOMR-F request, complete Sections A, B,and C. For Items E1–E4, use natural grade, if available. Check the measurement used. In Puerto Rico only, enter meters.					
E1. Provide elevation information for the following and check the appropriate boxes to show whether the elevation is above or below the highest adjacent grade (HAG) and the lowest adjacent grade (LAG).a) Top of bottom floor (including basement,					
crawlspace, or enclosure) is b) Top of bottom floor (including basement,		_			
crawlspace, or enclosure) is		feet mete			
E2. For Building Diagrams 6–9 with permanent flood ope the next higher floor (elevation C2.b in the diagrams) of the building is	enings provided in Sec	ction A Items 8 and/or			
E3. Attached garage (top of slab) is		_			
E4. Top of platform of machinery and/or equipment servicing the building is	Managari (Managari (Managa		_		
E5. Zone AO only: If no flood depth number is available,			ccordance with the community	s	
floodplain management ordinance?	No 📙 Unknown. T	he local official must	certify this information in Secti	ion G.	
SECTION F - PROPERTY OWNE	R (OR OWNER'S RE	PRESENTATIVE) C	ERTIFICATION		
The property owner or owner's authorized representative who completes Sections A, B, and E for Zone A (without a FEMA-issued or community-issued BFE) or Zone AO must sign here. The statements in Sections A, B, and E are correct to the best of my knowledge.					
Property Owner or Owner's Authorized Representative's Robert A. Echols, Jr., PE	Name				
Address 909 W. Apache	City Farmin	=	tate ZIP Code ew Mexico 87401)	
Signature	Date		elephone 05) 327-3303		
Comments					
			☐ Check here if attach	ments.	

ELEVATION CERTIFICATE

IMPORTANT: In these spaces, copy the corre	sponding information f	rom Section A.	FOR INSURANCE COMPANY USE	
Building Street Address (including Apt., Unit, Suite, and/or Bldg. No.) or P.O. Route and Box No. 27 Road 5777			Policy Number:	
City Farmington	State New Mexico	ZIP Code 87401	Company NAIC Number	
SECTIO	N G - COMMUNITY INF	ORMATION (OPTIONAL)		
The local official who is authorized by law or ordinance to administer the community's floodplain management ordinance can complete Sections A, B, C (or E), and G of this Elevation Certificate. Complete the applicable item(s) and sign below. Check the measurement used in Items G8–G10. In Puerto Rico only, enter meters.				
G1. The information in Section C was taken from other documentation that has been signed and sealed by a licensed surveyor, engineer, or architect who is authorized by law to certify elevation information. (Indicate the source and date of the elevation data in the Comments area below.) G2 A community official completed Section E for a building located in Zone A (without a FEMA-issued or community-issued BFE)				
G2. A community official completed Section or Zone AO.	on E for a ballaring located	a III Zone A (Without a T EN	in-issued of community-issued by Ey	
G3. The following information (Items G4–6	G10) is provided for comr	munity floodplain manager	nent purposes.	
G4. Permit Number	G5. Date Permit Issued		Date Certificate of Compliance/Occupancy Issued	
G7. This permit has been issued for: New Construction Substantial Improvement				
G8. Elevation of as-built lowest floor (including of the building:	basement)	fee	et meters Datum	
G9. BFE or (in Zone AO) depth of flooding at t	he building site:	fee	et meters Datum	
G10. Community's design flood elevation:		fee	et meters Datum	
Local Official's Name	-	Title		
Community Name	-	Telephone		
Signature	ו	Date		
Comments (including type of equipment and loc	ation, per C2(e), if applic	able)		
			Check here if attachments.	

BUILDING PHOTOGRAPHS

ELEVATION CERTIFICATE

See Instructions for Item A6.

IMPORTANT: In these spaces, copy the correspon	aing information fro	om Section A.	FOR INSURANCE COMPANY USE	
Building Street Address (including Apt., Unit, Suite, at 27 Road 5777	nd/or Bldg. No.) or P.	O. Route and Box No.	Policy Number:	
City	State	ZIP Code	Company NAIC Number	
Farmington	New Mexico	87401	Company NATO Number	
		U. 7U I		
If using the Elevation Certificate to obtain NFIP flood insurance, affix at least 2 building photographs below according to the instructions for Item A6. Identify all photographs with date taken; "Front View" and "Rear View"; and, if required, "Right Side View" and "Left Side View." When applicable, photographs must show the foundation with representative examples of the flood openings or vents, as indicated in Section A8. If submitting more photographs than will fit on this page, use the Continuation Page.				
	Photo One			
Photo One Caption			Clear Photo One	
	Photo Two			
Photo Two Caption			Clear Photo Two	


BUILDING PHOTOGRAPHS


ELEVATION CERTIFICATE


Continuation Page

MPORTANT: In these spaces, copy the corres	FOR INSURANCE COMPANY USE			
Building Street Address (including Apt., Unit, Suite, and/or Bldg. No.) or P.O. Route and Box No. 27 Road 5777			Policy Number:	
City Farmington	State New Mexico	ZIP Code 87401	Company NAIC Number	
If submitting more photographs than will fit on the preceding page, affix the additional photographs below. Identify all photographs with: date taken; "Front View" and "Rear View"; and, if required, "Right Side View" and "Left Side View." When applicable, photographs must show the foundation with representative examples of the flood openings or vents, as indicated in Section A8.				
	Photo Thre	pe		
Photo Three Caption			Clear Photo Three	
	Photo Fot	ır		
Photo Four Caption			Clear Photo Four	



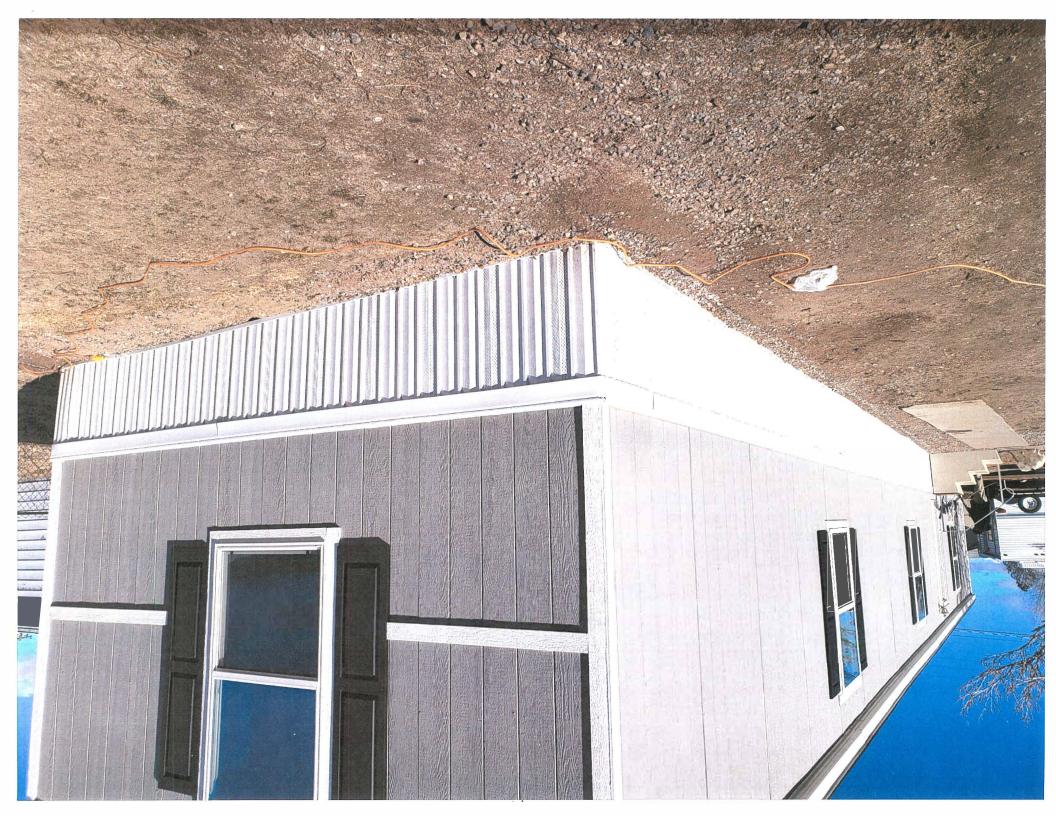

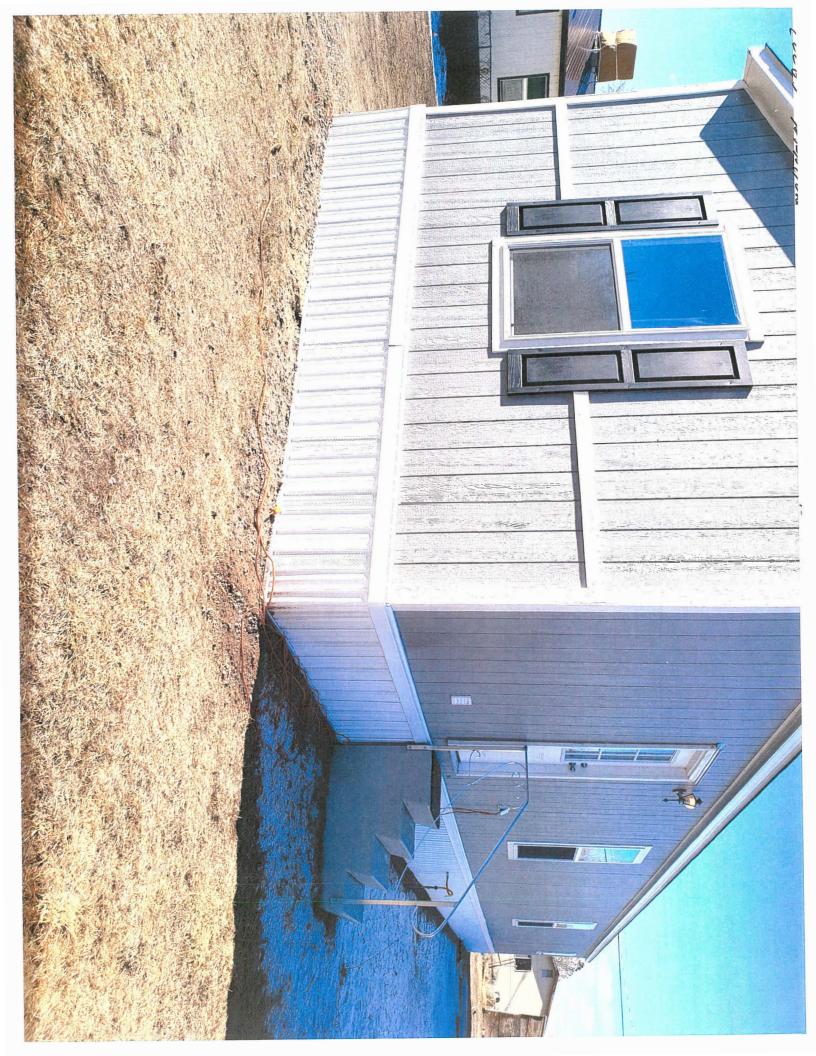


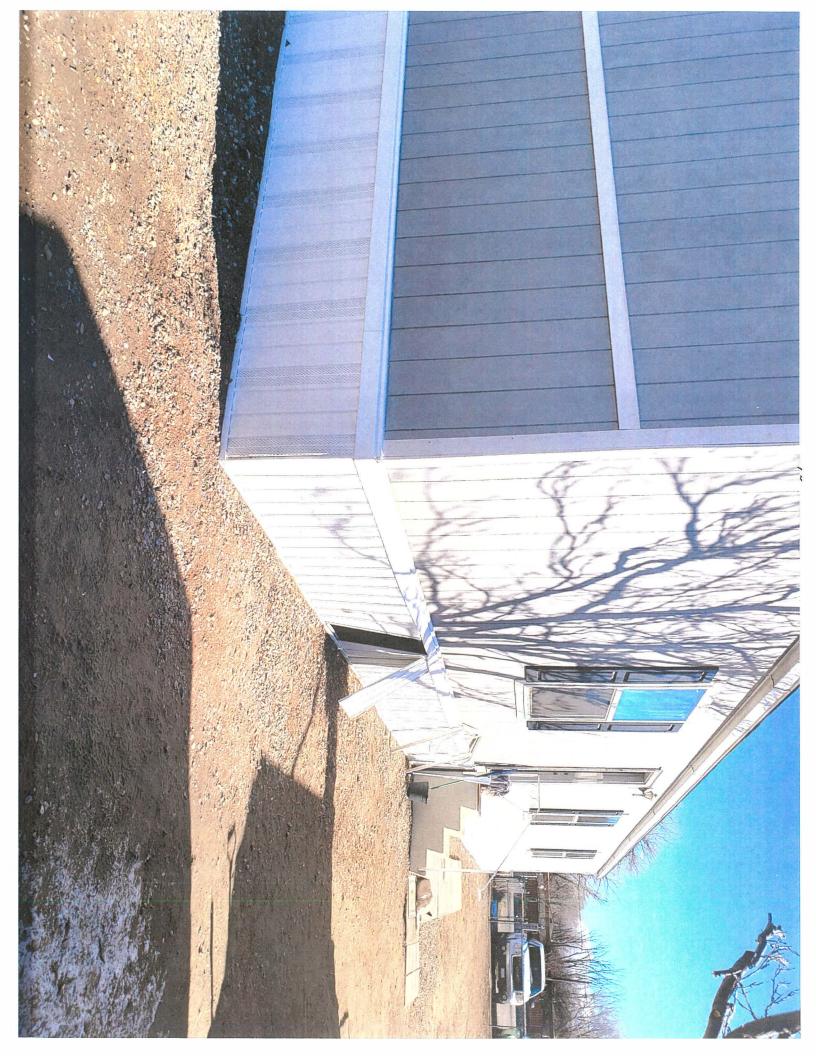

BASE FLOOD ELEVATION

I. DATA FROM PANEL 35045CIOIOF REVISED AUGUST 5, 2010 IS ZONE "AE". BASE FLOOD ELEVATION HAS BEEN DETERMINED = 5313.00. 2. SEE SHEET No. 2 OF 3 FOR FIRM MAP INFORMATION.


3. SEE SHEET No. 3 OF 3 FOR SAN JUAN RIVER PROFILE MAP 67P.

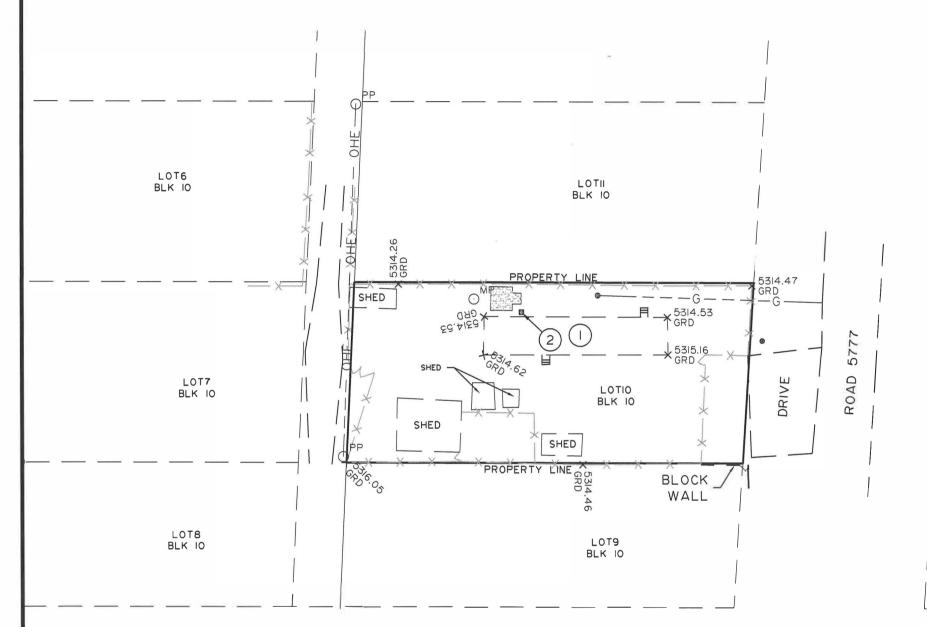

FLOOD ELEVATION CERTIFICATE No. 27 ROAD 5777 FARMINGTON, NEW MEXICO 87401 LOT 10, BLOCK 10 WILDHORSE VALLEY SUBDIVISION FOR BENNIE ARAGON


KEYED NOTES:

- (1) 1218.0 sf SINGLE WIDE MOBILE HOME No. 27. FINISH FLOOR ELEVATION = 5318.11. CRAWL SPACE ELEVATION = 5315.11.
- (2) SEWER CLEAN OUT TO SEPTIC TANK SYSTEM.

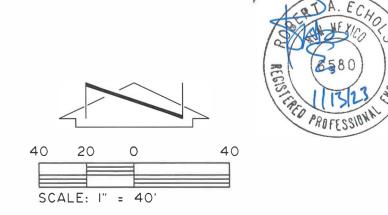





ISSUE DATE: 01/12/2023 PRINTED: January 12, 2023 FILE: D:\DWG-HWS\2022\22285\22285FLDCERT-0II223.dwg

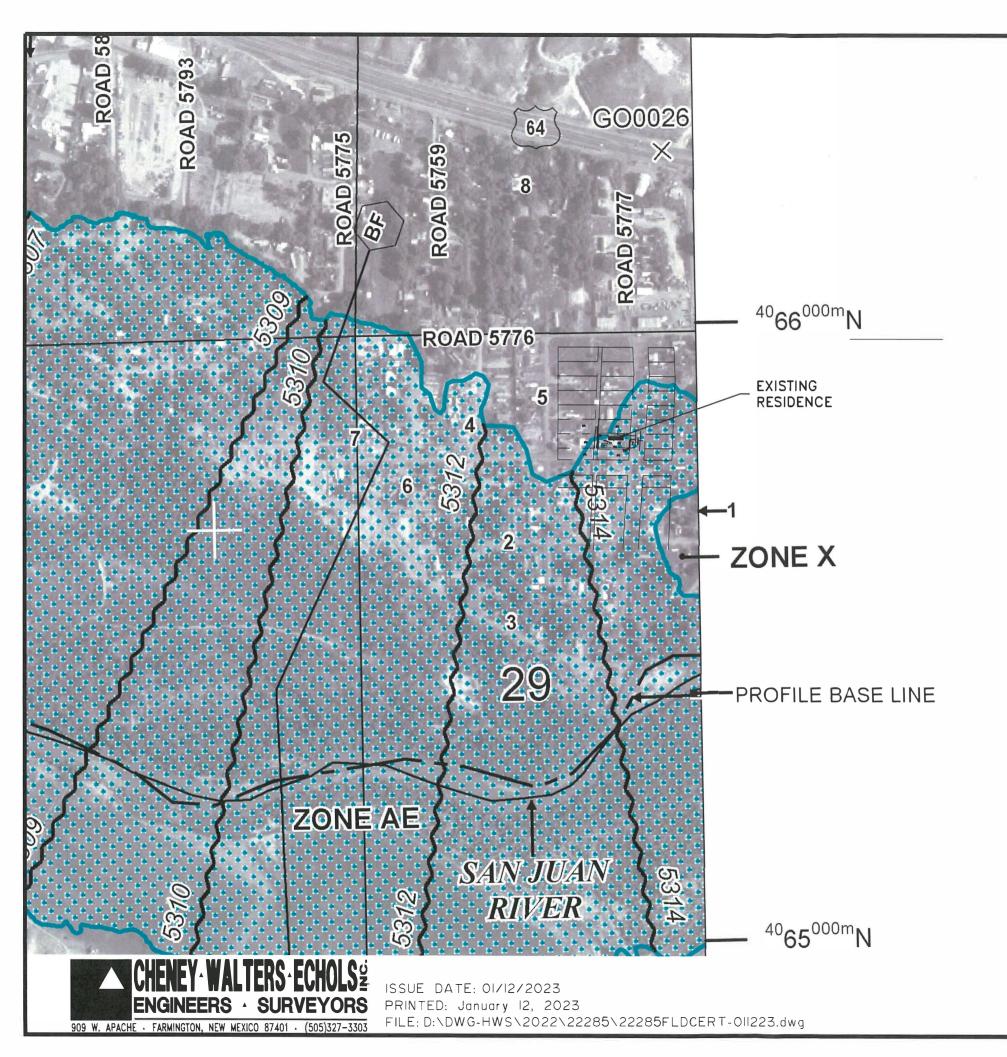


FLOOD ELEVATION CERTIFICATE
No. 27 ROAD 5777
FARMINGTON, NEW MEXICO 87401
LOT 10, BLOCK 10
WILDHORSE VALLEY SUBDIVISION
FOR
BENNIE ARAGON

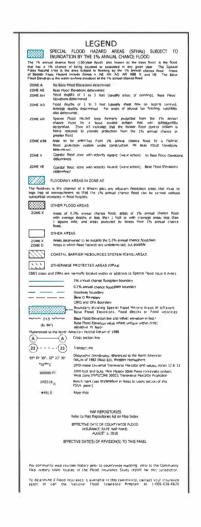

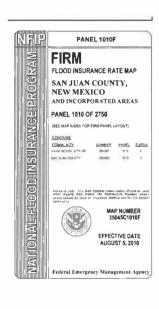




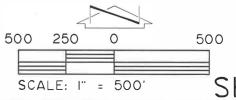

SHEET No. 2 OF 3

FLOOD ELEVATION CERTIFICATE
No. 27 ROAD 5777
FARMINGTON, NEW MEXICO 87401
LOT 10, BLOCK 10
WILDHORSE VALLEY SUBDIVISION
FOR

BENNIE ARAGON

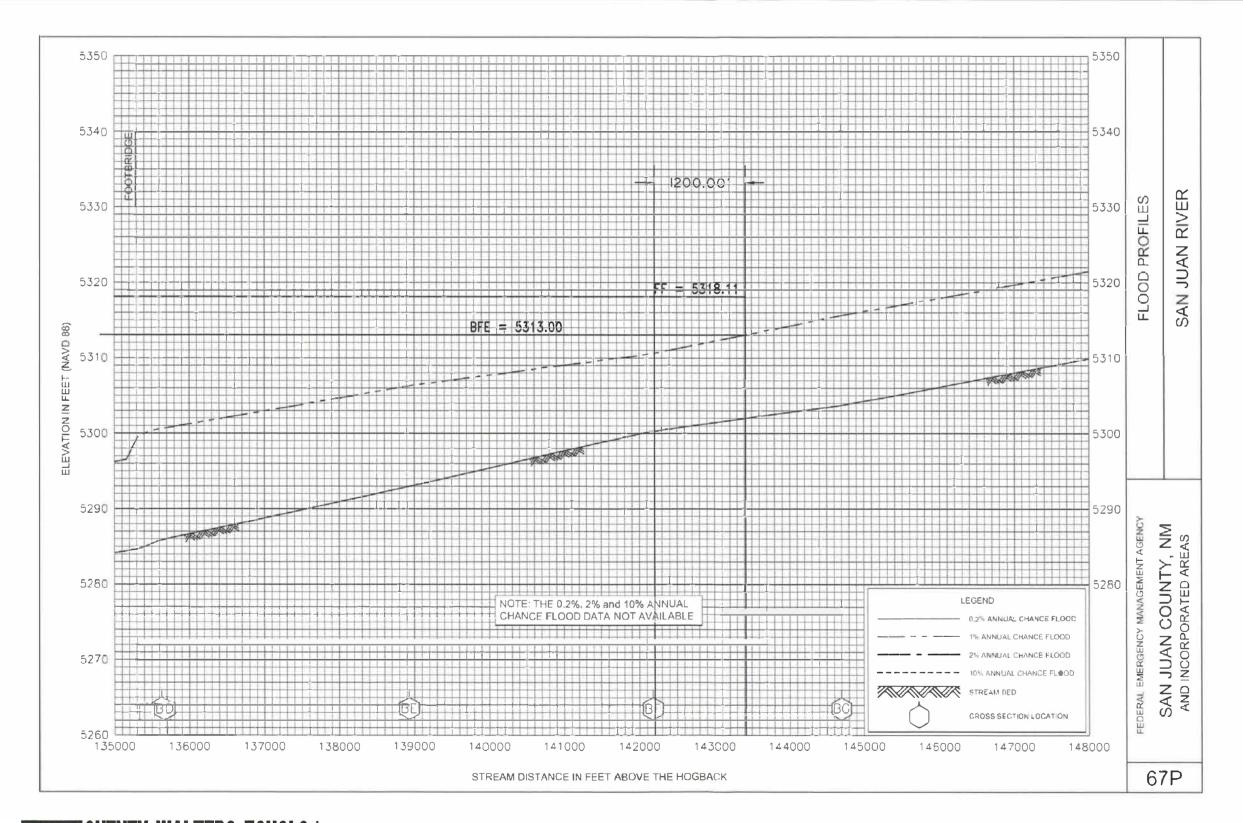





ISSUE DATE: 01/12/2023
PRINTED: January 12, 2023

327-3303 FILE: D:\DWG-HWS\2022\22285\22285FLDCERT-011223.dwg

SHEET No.3 OF3